

COPY

SIDE ONE

9/13/90
146

STATE CORPORATION COMMISSION OF KANSAS
OIL & GAS CONSERVATION DIVISION

WELL COMPLETION OR RECOMPLETION FORM
ACO-1 WELL HISTORY

DESCRIPTION OF WELL AND LEASE

KCC DISTRICT #2
FEB 14 1991
WICHITA, KS

Operator: License # 04511
Name William H. Davis
Address 2800 Mid-Continent Tower
City/State/Zip Tulsa, OK 74103

Purchaser

Operator Contact Person Mike Purdum
Phone (918) 587-7782

Contractor: License # 5418
Name Allen Drilling Company

Wellsite Geologist Paul Barker
Phone (918) 232-3100

Designate Type of Completion
 New Well Re-Entry Workover
 Oil SWD Temp Abd
 Gas Inj Delayed Comp.
 Dry Other (Core, Water Supply etc.)


If ONWO: old well info as follows:
Operator
Well Name
Comp. Date Old Total Depth

WELL HISTORY

Drilling Method:
 Mud Rotary Air Rotary Cable
10/19/89 10/25/89 10/26/89
Spud Date Date Reached TD Completion Date
3620
Total Depth PBTD

Amount of Surface Pipe Set and Cemented at 314 feet
Multiple Stage Cementing Collar Used? Yes No
If yes, show depth set.....feet
If alternate 2 completion, cement circulated
from.....feet depth to.....w/.....SX cmt

API NO. 15-077-21,201-00-00
County Harper
SW SE SE 32 32 Rge 5 East
330 Ft North from Southeast Corner of Section
990 Ft West from Southeast Corner of Section
(Note: Locate well in section plat below)
Lease Name Kuehn Well # 1
Field Name
Producing Formation
Elevation: Ground 1332 KB 1338

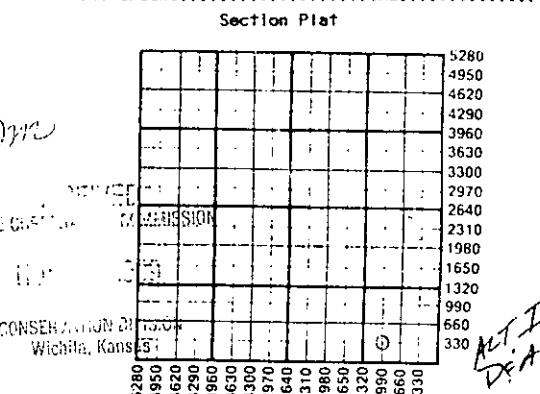

WATER SUPPLY INFORMATION
Disposition of Produced Water: Disposal Repressuring
Docket #

Questions on this portion of the ACO-1 call:
Water Resources Board (913) 296-3717
Source of Water:
Division of Water Resources Permit #
 Groundwater.....Ft North from Southeast Corner
(Well)Ft West from Southeast Corner of
Sec Twp Rge East West
 Surface Water 4620 Ft North from Southeast Corner
(Stream, pond etc) 4620 Ft West from Southeast Corner
Sec 7 Twp 33 Rge 5 East West
 Other (explain).....
(purchased from city, R.W.D. #)

INSTRUCTIONS: This form shall be completed in duplicate and filed with the Kansas Corporation Commission, 200 Colorado Dorby Building, Wichita, Kansas 67202, within 90 days after completion or recompletion of any well. Rule 82-3-150 and 82-3-107 apply.
Information on side two of this form will be held confidential for a period of 12 months if requested in writing and submitted with the form. See rule 82-3-107 for confidentiality in excess of 12 months.
One copy of all wireline logs and drillers time log shall be attached with this form. Submit CP-4 form with all plugged wells. Submit CP-111 form with all temporarily abandoned wells.

All requirements of the statutes, rules and regulations promulgated to regulate the oil and gas industry have been fully complied with and the statements herein are complete and correct to the best of my knowledge.

Signature [Signature] Date 11-10-89

Title Kansas Geological Survey NOV 28 1989
WICHITA BRANCH

Subscribed and sworn to before me this 10th day of November 1989

Notary Public [Signature]

Date Commission Expires 3/27/90

K.C.C. OFFICE USE ONLY
 Letter of Confidentiality Attached
 Wireline Log Received
 Drillers Timelog Received
Distribution
 KCC SWD/Rep NGPA
 KGS Plug Other (Specify)

Sec...Twp...Rge...

2

COPY SIDE TWO

Operator Name William H. Davis Lease Name Kuehn Well # 1


WELL LOG

INSTRUCTIONS: Show important tops and base of formations penetrated. Detail all cores. Report all drill stem tests giving interval tested, time tool open and closed, flowing and shut-in pressures, whether shut-in pressure reached static level, hydrostatic pressures, bottom hole temperature, fluid recovery, and flow rates if gas to surface during test. Attach extra sheet if more space is needed. Attach copy of log.

Drill Stem Tests Taken Yes No
 Samples Sent to Geological Survey Yes No
 Cores Taken Yes No

Stalnaker 3477-3491
 15-60-60-120
 Very slight blow. Rec. 1 ft. drlg. mud.
 IHP 1153'
 FHP 1153'

Formation Description
 Log Sample

Name	Top	Bottom
Howard Ln	2528	
Topeka	2766	
Heebner	3101	
Amazonia	3182	
Iaton Lime	3441	
Stalnaker	3471	

CASING RECORD <input checked="" type="checkbox"/> New <input type="checkbox"/> Used							
Report all strings set-conductor, surface, intermediate, production, etc.							
Purpose of String	Size Hole Drilled	Size Casing Set (in O.D.)	Weight Lbs/Ft.	Setting Depth	Type of Cement	#Sacks Used	Type and Percent Additives
Surface	12 1/4	8 5/8	23.5#	314	60/40	200	2% gel. & 3% cc
PERFORATION RECORD				Acid, Fracture, Shot, Cement Squeeze Record			
Shots Per Foot	Specify Footage of Each Interval Perforated			(Amount and Kind of Material Used)		Depth	
TUBING RECORD				Liner Run <input type="checkbox"/> Yes <input type="checkbox"/> No			
Date of First Production	Producing Method <input type="checkbox"/> Flowing <input type="checkbox"/> Pumping <input type="checkbox"/> Gas Lift <input type="checkbox"/> Other (explain)						
Estimated Production Per 24 Hours	Oil Bbls	Gas MCF	Water Bbls	Gas-Oil Ratio	Gravity		

METHOD OF COMPLETION

Production Interval

Disposition of gas: Vented Open Hole Perforation
 Sold Other (Specify)
 Used on Lease Dually Completed
 Commingled