

STATE CORPORATION COMMISSION OF KANSAS
OIL & GAS CONSERVATION DIVISION

WELL COMPLETION OR RECOMPLETION FORM
ACO-1 WELL HISTORY

DESCRIPTION OF WELL AND LEASE

Operator: License # 5123
Name Pickrell Drilling Company
Address 110 N. Market
Suite 205
City/State/Zip Wichita, Kansas 67202

Purchaser None

Operator Contact Person Jay McNeil
Phone

Contractor: License # 5123
Name Pickrell Drilling Company

Wellsite Geologist Bill Klaver
Phone (316)262-8427

Designate Type of Completion
 New Well Re-Entry Workover
 Oil SWD Temp Abd
 Gas Inj Delayed Comp.
 Dry Other (Core, Water Supply etc.)

If OWWO: old well info as follows:
Operator
Well Name
Comp. Date Old Total Depth

WELL HISTORY

Drilling Method:
 Mud Rotary Air Rotary Cable
11-5-84 11-12-84 11-12-84
Spud Date Date Reached TD Completion Date
4525
Total Depth PBDT

Amount of Surface Pipe Set and Cemented at 217 feet
Multiple Stage Cementing Collar Used? Yes No
If yes, show depth set feet
If alternate 2 completion, cement circulated
from feet depth to w/SX cmt

API NO. 15-077-21,048-00-00

County Harper

C E/2 SE NE Sec. 17 Twp. 31S Rge. 9 East West

3300 Ft North from Southeast Corner of Section
330 Ft West from Southeast Corner of Section
(Note: Locate well in section plat below)


Lease Name Anthony 'B' Well # 1

Field Name Spivey-Grabs

Producing Formation None

Elevation: Ground 1700 KB 1705

Section Plat

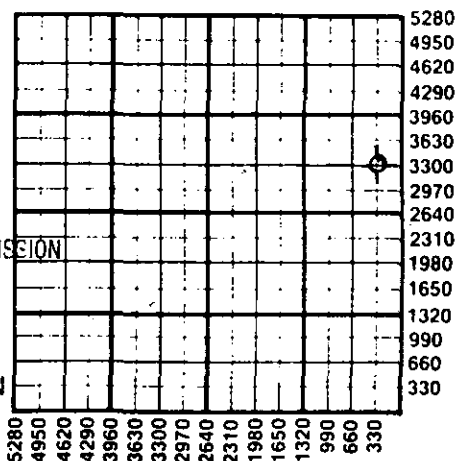

RECEIVED
STATE CORPORATION COMMISSION
11-27-84
NOV 27 1984
CONSERVATION DIVISION
Wichita, Kansas

WATER SUPPLY INFORMATION

Disposition of Produced Water: Disposal
Docket # Repressuring

Questions on this portion of the ACO-1 call:
Water Resources Board (913) 296-3717

Source of Water:
Division of Water Resources Permit # N/A

Groundwater Ft North from Southeast Corner
(Well) Ft West from Southeast Corner of
Sec Twp Rge East West

Surface Water 2500 Ft North from Southeast Corner
330 Ft West from Southeast Corner
Sec 17 Twp 31 Rge 9 East West

Other (explain) (purchased from city, R.W.D. #)

INSTRUCTIONS: This form shall be completed in duplicate and filed with the Kansas Corporation Commission, 200 Colorado Derby Building, Wichita, Kansas 67202, within 90 days after completion or recompletion of any well. Rule 82-3-130 and 82-3-107 apply.

Information on side two of this form will be held confidential for a period of 12 months if requested in writing and submitted with the form. See rule 82-3-107 for confidentiality in excess of 12 months.

One copy of all wireline logs and drillers time log shall be attached with this form. Submit CP-4 form with all plugged wells. Submit CP-111 form with all temporarily abandoned wells.

All requirements of the statutes, rules and regulations promulgated to regulate the oil and gas industry have been fully complied with and the statements herein are complete and correct to the best of my knowledge.

Signature C.W. Sebitts - Partner Date 11-19-84

Subscribed and sworn to before me this 19th day of November 1984
Notary Public Katherine J. Rule
Date Commission Expires June 29, 1988



K.C.C. OFFICE USE ONLY
F Letter of Confidentiality Attached
C Wireline Log Received
C Drillers Time Log Received
Distribution
 KCC SWD/Rep NGPA
 KGS Plug Other (Specify)

Sec. 1, Twp. 31S, Rge. 9W

Operator Name Pickrell Drilling Company Lease Name Anthony 'B' Well # 1

Sec. 17 Twp. 31S Rge. 9 East West County Harper

WELL LOG

INSTRUCTIONS: Show important tops and base of formations penetrated. Detail all cores. Report all drill stem tests giving interval tested, time tool open and closed, flowing and shut-in pressures, whether shut-in pressure reached static level, hydrostatic pressures, bottom hole temperature, fluid recovery, and flow rates if gas to surface during test. Attach extra sheet if more space is needed. Attach copy of log.

Drill Stem Tests Taken Yes No
 Samples Sent to Geological Survey Yes No
 Cores Taken Yes No

Formation Description
 Log Sample

Name Top Bottom

DST#1 3510'-3570', Hook would not set. (Hook @ 3582)	Heebner	3540(-1835)
DST#2 3510'-3570', Hook would not set. (Hook @ 3870)	Lansing	3752(-2047)
DST#3 3510'-3570', Misrun.	Stark	4174(-2469)
	Base Kansas City	4264(-2559)
	Cherokee	4400(-2695)
	Mississippian	4466(-2761)

CASING RECORD <input checked="" type="checkbox"/> New <input type="checkbox"/> Used Report all strings set-conductor, surface, intermediate, production, etc.							
Purpose of String	Size Hole Drilled	Size Casing Set (in O.D.)	Weight Lbs/Ft.	Setting Depth	Type of Cement	#Sacks Used	Type and Percent Additives
Surface	12 1/4"	8 5/8"	20#	217' KB	60/40poz	160	2% gel, 3% CC
PERFORATION RECORD				Acid, Fracture, Shot, Cement Squeeze Record			
Shots Per Foot	Specify Footage of Each Interval Perforated			(Amount and Kind of Material Used)		Depth	
TUBING RECORD				Liner Run <input type="checkbox"/> Yes <input type="checkbox"/> No			
Date of First Production		Producing Method <input type="checkbox"/> Flowing <input type="checkbox"/> Pumping <input type="checkbox"/> Gas Lift <input type="checkbox"/> Other (explain).....					
Estimated Production Per 24 Hours	Oil	Gas	Water	Gas-Oil Ratio	Gravity		
	Bbls	MCF	Bbls	CFPB			

METHOD OF COMPLETION

Production Interval

Disposition of gas: Vented Open Hole Perforation
 Sold Other (Specify)
 Used on Lease Dually Completed
 Commingled

