


STATE OF KANSAS
STATE CORPORATION COMMISSION

WELL PLUGGING RECORD

Give All Information Completely
Make Required Affidavit
Mail or Deliver Report to:
Conservation Division
State Corporation Commission
800 Bitting Building
Wichita, Kansas

Barber County. Sec. 2 Twp. 35S Rge. (E) 13 (W)
Location as "NE/CNW%SW%" or footage from lines Center NE/4-SW/4-NE/4
Lease Owner Amerada Petroleum Corporation
Lease Name L. Achenbach Well No. 1
Office Address Box 197 - Great Bend, Kansas
Character of Well (completed as Oil, Gas or Dry Hole) Dry Hole.
Date well completed Mar. 17, 19 57
Application for plugging filed Mar. 17, 19 57
Application for plugging approved Mar. 17, 19 57
Plugging commenced Mar. 17, 19 57
Plugging completed Mar. 17, 19 57
Reason for abandonment of well or producing formation Dry Hole.

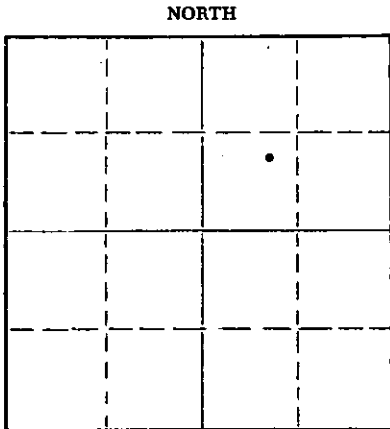

Locate well correctly on above
Section Plat

If a producing well is abandoned, date of last production _____ 19____
Was permission obtained from the Conservation Division or its agents before plugging was commenced? Yes

Name of Conservation Agent who supervised plugging of this well M.A. Rives of Pratt, Kansas
Producing formation _____ Depth to top _____ Bottom _____ Total Depth of Well 4961' Feet
Show depth and thickness of all water, oil and gas formations.

OIL, GAS OR WATER RECORDS

CASING RECORD

FORMATION	CONTENT	FROM	TO	SIZE	PUT IN	PULLED OUT
				8-5/8"	260'	None.

Describe in detail the manner in which the well was plugged, indicating where the mud fluid was placed and the method or methods used in introducing it into the hole. If cement or other plugs were used, state the character of same and depth placed, from _____ feet to _____ feet for each plug set.

Hole filled with heavy mud to 250' from top. Set bridge plug and 1/4 sack hulls at 250', spotted 20 sacks cement thru drill pipe, filled hole with mud to 30', set bridge plug & 1/4 sack hulls @ 30', mixed and dumped 10 sacks cement filling surface casing to top. Well plugged and abandoned as required by State Corporation Commission Representative Mr. M. A. Rives, Pratt, Kansas

(If additional description is necessary, use BACK of this sheet)

Name of Plugging Contractor Barbour Drilling Co.
Address Tulsa, Oklahoma

STATE OF Kansas COUNTY OF Barton, ss.
R. A. Drake (employee of owner) ~~owner or operator~~ of the above-described well, being first duly sworn on oath, says: That I have knowledge of the facts, statements, and matters herein contained and the log of the above-described well as filed and that the same are true and correct. So help me God.

(Signature) R. A. Drake

SUBSCRIBED AND SWORN to before me this 19th day of March, 19 57

My commission expires July 29, 1957

(Address) _____
RECEIVED Notary Public.
STATE CORPORATION COMMISSION

PLUGGING
FILE - SEC 2 T 35 R 13W
BOOK PAGE 149 LINE 5

MAR 20 1957
CONSERVATION DIVISION
Wichita, Kansas

Amerada Petro

WELL LOG

L. Achenbach #1 - Cen. NE/4--SW/4-NE/4 - Sec. 2-35S-13W, Barber County, Kans.

<u>From</u>	<u>To</u>	
0'	264'	Red Bed.
264'	620'	Red Bed & Shale.
620'	1330'	Shale.
1330'	1727'	Shale & Lime.
1727'	1785'	Shale.
1785'	1878'	Anhydrite.
1878'	2215'	Lime.
2215'	2240'	Shale & Lime.
2240'	2585'	Lime.
2585'	2765'	Shale & Lime.
2765'	2993'	Lime & Shale.
2993'	3110'	Shale & Lime.
3110'	3628'	Lime & Shale.
3628'	3662'	Shale & Lime.
3662'	3680'	Sand.
3680'	3863'	Sandy Shale & Lime.
3863'	4055'	Lime & Shale.
4055'	4172'	Shale & Lime.
4172'	4244'	Lime.
4244'	4488'	Lime & Shale.
4488'	4835'	Lime.
4835'	4840'	Sandy Lime.
4840'	4860'	Lime.
4860'	4876'	Cherty Lime.
4876'	4896'	Lime.
4896'	4918'	Cherty Lime.
4918'	4961'	Lime.

PLUGGING
FILE SEC 2 T 35 R 13W
BOOK PAGE 149 LINE 5

RECEIVED
STATE CORPORATION COMMISSION

MAR 20 1957

CONSERVATION DIVISION
Wichita, Kansas