


STATE OF KANSAS  
STATE CORPORATION COMMISSION

WELL PLUGGING RECORD

Give All Information Completely  
Make Required Affidavit  
Mail or Deliver Report to:  
Conservation Division  
State Corporation Commission  
800 Bitting Building  
Wichita, Kansas

Barber County. Sec. 3 Twp. 35 Rge. 13 (E/W (W))  
Location as "NE/CNW/SW" or footage from lines SE NE NE  
Lease Owner City Products Corporation, c/o W. J. Coppinger  
Lease Name Pierson Well No. 1  
Office Address 320 Union National Bank Bldg., Wichita, Ks.  
Character of Well (completed as Oil, Gas or Dry Hole) dry hole  
Date well completed May 21 19 55  
Application for plugging filed May 21 19 55  
Application for plugging approved May 21 19 55  
Plugging commenced May 21 19 55  
Plugging completed May 21 19 55  
Reason for abandonment of well or producing formation \_\_\_\_\_

NORTH

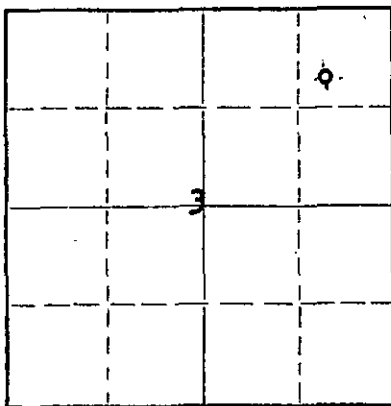

Locate well correctly on above Section Plat

If a producing well is abandoned, date of last production \_\_\_\_\_ 19\_\_\_\_  
Was permission obtained from the Conservation Division or its agents before plugging was commenced? yes

Name of Conservation Agent who supervised plugging of this well Merle Rives, Pratt, Ks.  
Producing formation \_\_\_\_\_ Depth to top \_\_\_\_\_ Bottom \_\_\_\_\_ Total Depth of Well 1823 Feet  
Show depth and thickness of all water, oil and gas formations.

OIL, GAS OR WATER RECORDS

CASING RECORD

FORMATION	CONTENT	FROM	TO	SIZE	PUT IN	PULLED OUT

Describe in detail the manner in which the well was plugged, indicating where the mud fluid was placed and the method or methods used in introducing it into the hole. If cement or other plugs were used, state the character of same and depth placed, from \_\_\_\_\_ feet to \_\_\_\_\_ feet for each plug set.

Filled hole with mud laden fluid and set plug at 350' from top; cemented with 20 sax; filled to 35' of top; pushed plug down; cemented with 10 sax cement.

RECEIVED  
MAY 26 1955  
5-25-55  
CONSERVATION DIVISION  
Wichita, Kansas

(If additional description is necessary, use BACK of this sheet)  
Name of Plugging Contractor W. J. Coppinger  
Address Wichita, Kansas

STATE OF Kansas, COUNTY OF Sedgwick ss.  
Lee Paulsen (employee of City Products Corporation) of the above-described well, being first duly sworn on oath, says: That I have knowledge of the facts, statements, and matters herein contained and the log of the above-described well as filed and that the same are true and correct. So help me God.

(Signature) Lee Paulsen  
320 Union Natl Bk Bldg., Wichita, Ks.  
(Address)

SUBSCRIBED AND SWORN TO before me this 23rd day of May, 19 55

March 7, 1956  
Mayree Broadus  
Notary Public.

My commission expires \_\_\_\_\_

PLUGGING  
FILE SEC 3 T 35 R 13W  
BOOK PAGE 120 LINE 41

DRILLERS LOG

Re:  
 City Products Corporation, Owner  
 W. J. Coppinger, Contractor  
 320 Union National Bank Bldg.  
 Wichita 2, Kansas

Re: Pierson #1  
 SE NE NE Sec. 3-35s-13w  
 Barber County, Kansas

Elevation: 1508 R.B.  
 1505 D.F.  
 1497 G.L.

Commenced: April 30, 1955  
 Completed: May 21, 1955

Tops: (Sample)

Red Bed 50  
 Red bed and sand 135  
 Red bed and shells 358  
 Red bed and shale 750  
 Red bed, shale, shells 925  
 Shale and shells 1350  
 Salt and shale 1435  
 Shale and lime, shells 1735  
 Lime and shale 2955  
 Shale and shells 3070  
 Shale and lime 3680  
 Shale and sand 3860  
 Shale and lime 3918  
 Lime 3980  
 Sand 3998

LeCompton 3638  
 Elgin Sand 3680  
 Base Elgin 3819  
 Heebner 3879  
 Toronto 3900  
 Douglas Sand 3980  
 Lansing 4094

Marmaton 4627  
 Mississippi 4799

R T D 4823

D & A

Sand and shale 4035  
 Lime 4070  
 Lime and shale 4102  
 Lime 4240  
 Lime and shale 4290  
 Lime 4300  
 Lime and shale 4470  
 Lime 4565  
 Lime and shale 4805  
 Lime 4823

R T D 4823

STATE OF KANSAS, COUNTY OF SEDGWICK, SS.

I, the undersigned, being duly sworn on oath state that the above statement and log is a true record and log of the well drilled at the location above described.

*Lee Poulsen*  
 Lee Poulsen

Subscribed and sworn to before me this 23rd day of May 1955.

My Commission expires: March 7, 1956

*Mayrée Broadus*  
 Mayrée Broadus, Notary Public



RECEIVED  
 STATE CORPORATION COMMISSION  
 MAY 26 1955  
 CONSERVATION DIVISION  
 Wichita, Kansas

PLUGGING  
 FILE SEC 3 T 35 R 13W  
 BOOK PAGE 20 LINE 41