


15-007-20512-00-00

STATE OF KANSAS  
STATE CORPORATION COMMISSION

WELL PLUGGING RECORD

Give All Information Completely.  
Make Required Affidavit  
Mail or Deliver Report to  
Conservation Division  
State Corporation Comm.  
245 North Water  
Wichita, KS 67202

Barber County, Sec. 3 Twp. 35 Rge. 13 NW  
Location as "NE/CNW $\frac{1}{4}$ /SW $\frac{1}{4}$ " or footage from lines  
NE NE NW  
Lease Owner Okmar Oil Company  
Lease Name Carlos Well No. 1  
Office Address 970 Fourth Financial Ctr. Wichita, KS 67202  
Character of Well (Completed as Oil, Gas or Dry Hole)

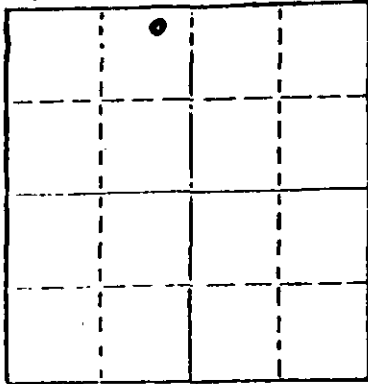

Locate well correctly on above  
Section Plot

Dry Hole  
Date Well completed July 10 1977  
Application for plugging filed January 25 1978  
Application for plugging approved 19  
Plugging commenced 3:00 P.M. July 10 1977  
Plugging completed 5:00 P.M. July 10 1977  
Reason for abandonment of well or producing formation  
Dry

If a producing well is abandoned, date of last production 19

Was permission obtained from the Conservation Division or its agents before plugging was commenced? Yes

Name of Conservation Agent who supervised plugging of this well Duane Rankin  
Producing formation Depth to top Bottom Total Depth of Well 4940'  
Show depth and thickness of all water, oil and gas formations.

OIL, GAS OR WATER RECORDS

CASING RECORD

FORMATION	CONTENT	FROM	TO	SIZE	PUT IN	PULLED OUT
				8 5/8"	255'	None

Describe in detail the manner in which the well was plugged, indicating where the mud fluid was placed and the method or methods used in introducing it into the hold. If cement or other plugs were used, state the character of same and depth placed, from feet to feet for each plug set.

Plug at 240' with 40 sx.;  
at 40' with 10 sx.  
5 sx. Rathole

RECEIVED  
STATE CORPORATION COMMISSION

JAN 27 1978 1:27:78

CONSERVATION DIVISION  
Wichita, Kansas

(If additional description is necessary, use BACK of this sheet)

Name of Plugging Contractor Gabbert-Jones, Inc.


STATE OF Kansas COUNTY OF Sedgwick, ss.  
Don Beauchamp (employee of owner) or (owner or operator)

of the above-described well, being first duly sworn on oath, says: That I have knowledge of the facts, statements, and matters herein contained and the log of the above-described well as filed and that the same are true and correct. So help me God.

(Signature)

*Don Beauchamp*  
970 Fourth Financial Ctr. Wichita, KS 67202  
(Address)

SUBSCRIBED AND SWORN TO before me this 26th day of January, 1978

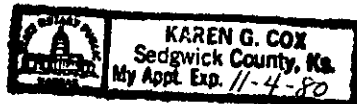

*Karen G. Cox*  
Notary Public.

My commission expires

GABBERT-JONES, INC.  
 WICHITA, KANSAS  
 DRILLERS' WELL LOG

Carlos #1  
 NE NE NW Sec 3-35S-13W  
 Barber County Kansas

Commenced: 6-30-77

Completed: 7-10-77

OPERATOR: BEREN CORPORATION

Depth		Formation	Remarks
From	to		
0	263	Shale	Ran 6 jts of 24# 8 5/8" csg
263	1196	Redbed-Shale	set @ 255' Cemented w/
1196	2158	Shale-Gyp	175 sks Common 2% Gel
2158	2560	Shale-Lime	3% CC PD @ 2:30 a.m.
2560	4200	Lime-Shale	7-1-77
4200	4750	Lime	
4750	4825	Lime-Shale	
4825	4940	Lime	
	4940 - TD		DRY & ABANDONED

STATE OF KANSAS )  
 ) SS  
 COUNTY OF SEDGWICK))

I, the undersigned, being duly sworn on oath, state that the above Drillers' Well Log is true and correct to the best of my knowledge and belief and according to the records of this office.

GABBERT-JONES, INC.

*James S. Sutton II*  
 JAMES S. SUTTON II

Subscribed and sworn to before me this 14th day of July, 1977.

*Elizabeth J. Edwards*  
 ELIZABETH J. EDWARDS-NOTARY PUBLIC

My Commission expires February 6, 1979.

