


STATE OF KANSAS  
STATE CORPORATION COMMISSION

WELL PLUGGING RECORD

Give All Information Completely  
Make Required Affidavit  
Mail or Deliver Report to:  
Conservation Division  
State Corporation Commission  
800 Bitting Building  
Wichita, Kansas

Barber County. Sec. 5 Twp 35 Rge. 13 (E) W (W)  
Location as "NE/CNW&SW" or footage from lines SW NW NW  
Lease Owner City Products Corp. & Continental Oil Co.  
Lease Name Walsh (Sternberger) Well No. 1  
Office Address c/o 320 Union Natl Bk Bldg., Wichita, Ks.  
Character of Well (completed as Oil, Gas or Dry Hole) dry hole  
Date well completed April 28 19 55  
Application for plugging filed April 28 19 55  
Application for plugging approved April 28 19 55  
Plugging commenced April 28 19 55  
Plugging completed April 29 19 55  
Reason for abandonment of well or producing formation -

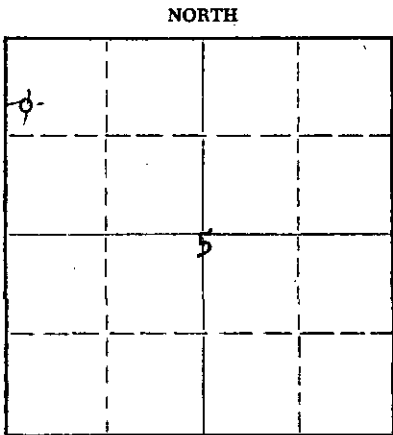

Locate well correctly on above  
Section Plat

If a producing well is abandoned, date of last production - 19 -  
Was permission obtained from the Conservation Division or its agents before plugging was commenced? yes

Name of Conservation Agent who supervised plugging of this well Merle Rives, Pratt, Ks.  
Producing formation \_\_\_\_\_ Depth to top \_\_\_\_\_ Bottom \_\_\_\_\_ Total Depth of Well 5650 Feet  
Show depth and thickness of all water, oil and gas formations.

OIL, GAS OR WATER RECORDS

CASING RECORD

FORMATION	CONTENT	FROM	TO	SIZE	PUT IN	PULLED OUT

Describe in detail the manner in which the well was plugged, indicating where the mud fluid was placed and the method or methods used in introducing it into the hole. If cement or other plugs were used, state the character of same and depth placed, from \_\_\_\_\_ feet to \_\_\_\_\_ feet for each plug set.

Filled hole with mud laden fluid to 300' of top  
Cemented with 35 sax cement;  
filled hole to 35' of top and  
Cemented with 15 sax.

RECEIVED  
STATE CORPORATION COMMISSION  
MAY 3 1955  
5.3.55  
CONSERVATION DIVISION  
Wichita, Kansas

(If additional description is necessary, use BACK of this sheet)  
Name of Plugging Contractor W J Coppinger  
Address 320 Union Natl Bk Bldg., Wichita, Ks.

STATE OF Kansas, COUNTY OF Sedgwick, ss.  
Lee Poulsen (employee of ~~owner~~ or ~~lessee~~ or operator) of the above-described well, being first duly sworn on oath, says: That I have knowledge of the facts, statements, and matters herein contained and the log of the above-described well as filed and that the same are true and correct. So help me God.  
(Signature) Lee Poulsen  
Wichita, Kansas (Address)

SUBSCRIBED AND SWORN TO before me this 29th day of April 19 55  
Mayree Broadus Notary Public.  
My commission expires March 7, 1956

PLUGGING  
FILE SEC 5 T 35 R 13W  
BOOK PAGE 115 LINE 32

DRILLERS LOG

Owner: City Products Corporation and  
Continental Oil Company

Re: Walsh #1 -  
SW NW NW Sec. 5-35s-13w  
Barber County, Kansas

Contractor: W. J. Coppinger  
320 Union Natl Bk Bldg.  
Wichita, Kansas

Elevation: 1639 R.B.  
1636 D.F.

Commenced: March 31, 1955  
Completed: April 28, 1955

Casing Record:

13-3/8" set at 310' w/350 ex  
posmix cement

Red bed and shells	310
Red bed and shale	785
Red bed, shale & shells	1150
Shale and shells	1400
Shale and salt	1575
Shale and lime	1620
Shale and lime shells	1670
Anhydrite	1705
Shale and lime	3500
Shale	3790
Lime and shale	3815
Sand and shale	3900
Shale	3990
Lime and shale	4190
Shale	4218
Lime	4250
Lime and shale	4300
Lime	4370
Lime and shale	4610
Lime	4645
Lime and shale	4852
Lime	4920
Lime and shale	5140
Lime	5163
Shale and lime	5260
Lime	5325
Cherty lime	5355
Chert	5364
Cherty lime	5379
Cherty lime and shale	5433
Shale and sand	5466
Shale	5510
Shale and sand	5575
Lime and shale	5650
R T D	5650

Tops:

Anhydrite	1670
LeCompton	3798
Elgin Zone	3813
Heebner	4022
Toronto	4046
Douglas Group	4104
Douglas Sand	4135
Lansing	4218
Mississippi	4840
Kinderhook Lime	5142
Kinderhook Shale	5167
Chattanooga Shale	5199
Maquoketa	5233
Viola Lime	5266
Simpson Shale	5403
Simpson Dolomite	5407
Simpson Sand	5442
Arbuckle	5588
R T D	5650

D & A

Dry and abandoned

RECEIVED  
STATE CORPORATION COMMISSION  
MAY 3 X 1955  
CONSERVATION DIVISION  
Wichita, Kansas

State of Kansas, County of Sedgwick, ss.

I, the undersigned, being duly sworn on oath, state that the above statement and log is a true record and log of the well drilled at the above described location.

Subscribed and sworn to before me this 29th day  
of April, 1955.

My commission expires:  
March 7, 1956

*Mayree Broadbus*  
Mayree Broadbus, Notary Public

*Lee Paulsen*

PLUGGING  
WELL SEC 5 T 35 R 13W  
BOOK PAGE 115 LINE 72

