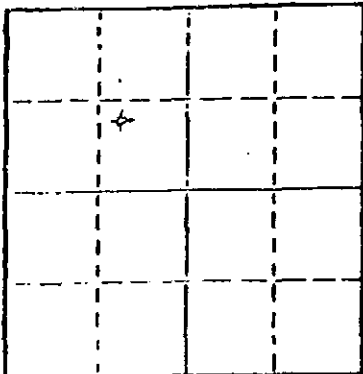


STATE OF KANSAS  
STATE CORPORATION COMMISSION

WELL PLUGGING RECORD

Give All Information Completely  
Make Required Affidavit  
Mail or Deliver Report to  
Conservation Division  
State Corporation Comm.  
245 North Water  
Wichita, KS 67202

Barber County, Sec. 25 Twp. 30S Rge. 13 E/W  
Location as "NE/CNW $\frac{1}{4}$ SW $\frac{1}{4}$ " or footage from lines  
C NW/4 SE/4 NW/4  
Lease Owner Gould Oil, Inc.  
Lease Name Stumph Well No. 1  
Office Address 260 N. Rock Road, Suite 210, Wichita, Ks. 67206  
Character of Well (Completed as Oil, Gas or Dry Hole) Dry Hole  
Date Well completed May 6, 1979  
Application for plugging filed Verbal 19  
Application for plugging approved Verbal 19  
Plugging commenced May 6, 1979  
Plugging completed May 6, 1979  
Reason for abandonment of well or producing formation D & A  
If a producing well is abandoned, date of last production 19



Locate well correctly on above  
Section Plot

Was permission obtained from the Conservation Division or  
its agents before plugging was commenced? Yes

Name of Conservation Agent who supervised plugging of this well Verbal  
Producing formation \_\_\_\_\_ Depth to top \_\_\_\_\_ Bottom \_\_\_\_\_ Total Depth of Well \_\_\_\_\_  
Show depth and thickness of all water, oil and gas formations.

OIL, GAS OR WATER RECORDS

CASING RECORD

FORMATION	CONTENT	FROM	TO	SIZE	PUT IN	PULLED OUT
				8 5/8"	318'	-0-

Describe in detail the manner in which the well was plugged, indicating where the mud fluid  
was placed and the method or methods used in introducing it into the hold. If cement or other  
plugs were used, state the character of same and depth placed, from \_\_\_\_\_ feet to  
\_\_\_\_\_ feet for each plug set.

40 sacks @ 320'  
12 sacks @ 40'

RECEIVED  
STATE CORPORATION COMMISSION

MAY 14 1979  
5-14-79

(If additional description is necessary, use BACK of ~~THIS SHEET~~ VISION  
Name of Plugging Contractor Eagle Drilling, Inc. Wichita, Kansas

STATE OF KANSAS COUNTY OF SEDGWICK, ss.  
James G. Gould (employee of owner) or (owner or operator)  
of the above-described well, being first duly sworn on oath, says: That I have knowledge of  
the facts, statements, and matters herein contained and the log of the above-described well  
as filed and that the same are true and correct. So help me God.

(Signature) James G. Gould  
James G. Gould  
260 N. Rock Road, Wichita, Ks.  
(Address)

SUBSCRIBED AND SWORN TO before me this 10th day of May, 19 79

Leola Lynskey  
Leola Lynskey Notary Public.

My commission expires March 20, 1983

LEOLA LYNKEY  
STATE NOTARY PUBLIC  
SEDGWICK COUNTY, KANSAS  
MY APPT. EXPIRES 3-20-83

DRILLER'S LOG

Operator: Gould Oil, Inc.  
Lease Name: Stumph #1  
Spot Location: C NW SE NW  
Sec. 25-30S-13W  
County, State: Barber County, Kansas

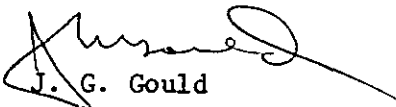
Commenced: 4-28-79  
Completed: 5-6-79

Surface Casing: 8 jts. 8 5/8" used casing  
set @ 318 with 250 sacks common, 3% CaCl, 2% gel.

<u>FORMATION</u>	<u>DEPTH</u>
Red Bed	0-1174
Shale	1174-1955
Shale & Lime	1955-2580
Lime & Shale	2580-2860
Shale & Lime	2860-3380
Lime & Shale	3380-3610
Lime	3610-3654
Shale & Lime	3654-3713
Lime & Shale	3713-4007
Shale & Lime	4007-4185
Lime	4185-4415
	4415-T.D.

I do hereby certify that the foregoing statements are true and correct to the best of my knowledge and belief.

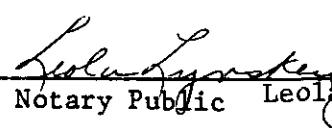
EAGLE DRILLING, INC. RECEIVED  
STATE CORPORATION COMMISSION  
MAY 14 1979  
CONSERVATION DIVISION  
Wichita, Kansas

  
J. G. Gould

STATE OF KANSAS )  
COUNTY OF SEDGWICK ) ss:

Subscribed and sworn to before me this 10th day of May, 79.

**LEOLA LYNKEY**  
My appointment as **STATE NOTARY PUBLIC**  
MY APPT. EXPIRES 3-20-83

  
Notary Public Leola Lynskey