


STATE OF KANSAS
STATE CORPORATION COMMISSION

WELL PLUGGING RECORD

Give All Information Completely
Make Required Affidavit
Mail or Deliver Report to:
Conservation Division
State Corporation Commission
211 No. Broadway
Wichita, Kansas

Barber County, Sec. 6 Twp. 34S Rge. 15 (E) W (W)
Location as "NE/CNWxSWx" or footage from lines. C SE NE
Lease Owner Honaker-Davis Drlg. Co.
Lease Name Platt Well No. 1
Office Address 2008 Lakin, Great Bend, Kansas
Character of Well (completed as Oil, Gas or Dry Hole) Dry Hole
Date well completed 10-15 19 57
Application for plugging filed 10-15 19 57
Application for plugging approved 10-15 19 57
Plugging commenced 2:00 A.M. 10-16 19 57
Plugging completed 4:00 A.M. 10-16 19 57
Reason for abandonment of well or producing formation Dry Hole

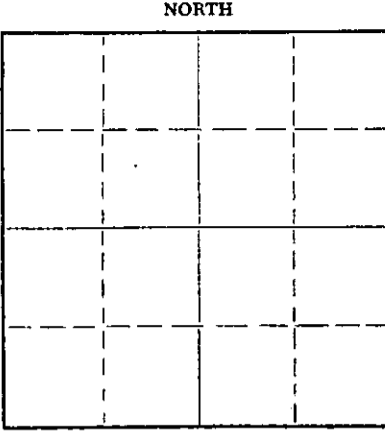

Locate well correctly on above
Section Plat

If a producing well is abandoned, date of last production _____ 19____
Was permission obtained from the Conservation Division or its agents before plugging was commenced? yes by phone

Name of Conservation Agent who supervised plugging of this well Mr. Rives
Producing formation _____ Depth to top _____ Bottom _____ Total Depth of Well 5300 Feet
Show depth and thickness of all water, oil and gas formations.

OIL, GAS OR WATER RECORDS

CASING RECORD

FORMATION	CONTENT	FROM	TO	SIZE	PUT IN	PULLED OUT
				8 5/8	902	None

Describe in detail the manner in which the well was plugged, indicating where the mud fluid was placed and the method or methods used in introducing it into the hole. If cement or other plugs were used, state the character of same and depth placed, from _____ feet to _____ feet for each plug set.

Filled hole with heavy rotary mud to 300'. 1/3 sack hulls and plug at 300'. Mixed 20 sacks cement through drill pipe.

Filled hole with heavy rotary mud to 35'. 1/3 sack hulls and plug at 35'. Mixed 10 sacks cement and filled hole to bottom of cellar with cement.

10-19-57
OCT 23 1957
CONSERVATION DIVISION
Wichita, Kansas

(If additional description is necessary, use BACK of this sheet)
Name of Plugging Contractor Honaker-Davis Drlg. Co.
Address 2008 Lakin, Great Bend, Kansas

STATE OF KANSAS, COUNTY OF BARTON, ss.
S. C. Lingreen (employee of owner) or (owner or operator) of the above-described well, being first duly sworn on oath, says: That I have knowledge of the facts, statements, and matters herein contained and the log of the above-described well as filed and that the same are true and correct. So help me God.

(Signature) S. C. Lingreen
2008 Lakin, Great Bend, Kansas
(Address)

SUBSCRIBED AND SWORN TO before me this 18th day of October 19 57
Kenneth G. Fischer
Kenneth G. Fischer, Notary Public.
My commission expires 6-25-59

PLUGGING
FILE SEC 6 T. 34 R15W
BOOK PAGE 54 LINE 27

DRILLERS' LOG

Platt No. 1
Loc: Ctr. SE NE
Sec: 6-34S-15W
Barber County, Kansas
Company: Honaker-Davis Drlg. Co., et al
Contractor: Honaker-Davis Drlg. Co.

Comm: 9-23-57
Comp: 10-16-57
Rotary Total Depth: 5300'
Casing: 8-5/8" at 902'
D & A

0	100	Sand	8-5/8" casing cemented at 902' with 450 sacks cement and 2% calcium chloride.
100	910	Red Bed	
910	1511	Shale & Gyp	
1511	1850	Shale & Shells	
1850	3500	Lime & Shale	
3500	3650	Shale & Lime	
3650	4080	Lime & Shale	
4080	4160	Lime	
4160	4215	Lime & Shale	
4215	4245	Lime	
4245	4405	Lime & Shale	
4405	4510	Lime	
4510	5100	Lime & Shale	
5100	5102	Chert	
5102	5120	Lime & Chert	
5120	5235	Lime	
5235	5285	Lime & Shale	
5285	5300	Lime	
5300		Total Rotary Depth	D & A

I certify that this is the true and correct copy of the above log to the best of my knowledge.

H. S. Forbes

Subscribed and sworn to before me this 18th day of October, 1957.

Kenneth G. Fischer, Notary Public

My commission expires: 6-25-59

PLUGGING
FILE SEC. 6 T. 34 R. 15W
BOOK PAGE 54 LINE 27

OCT 19 1957

REGISTRATION DIVISION
Kansas