


WELL PLUGGING RECORD

Give All Information Completely
Make Required Affidavit
Mail or Deliver Report to:
Conservation Division
State Corporation Commission
211 No. Broadway
Wichita, Kansas

Harper County. Sec. 1 Twp. 34S Rge. 15W (E) (W)
Location as "NE/CNW/SW" or footage from lines. Gen. SW SW
Lease Owner Gralapp & Everly
Lease Name Murdock "B" Well No. 1
Office Address State Bank Bldg., Winfield, Kansas
Character of Well (completed as Oil, Gas or Dry Hole) Dry
Date well completed May 11 19 59
Application for plugging filed May 11 19 59
Application for plugging approved May 11 19 59
Plugging commenced May 11 19 59
Plugging completed May 11 19 59
Reason for abandonment of well or producing formation _____

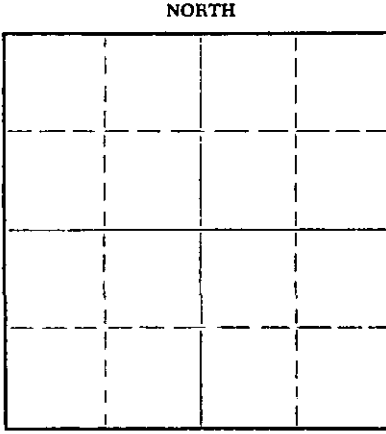

Locate well correctly on above Section Plat

If a producing well is abandoned, date of last production _____ 19____
Was permission obtained from the Conservation Division or its agents before plugging was commenced? yes

Name of Conservation Agent who supervised plugging of this well Gene Graham
Producing formation _____ Depth to top _____ Bottom _____ Total Depth of Well 4852 Feet
Show depth and thickness of all water, oil and gas formations.

OIL, GAS OR WATER RECORDS

CASING RECORD

FORMATION	CONTENT	FROM	TO	SIZE	PUT IN	PULLED OUT

Describe in detail the manner in which the well was plugged, indicating where the mud fluid was placed and the method or methods used in introducing it into the hole. If cement or other plugs were used, state the character of same and depth placed, from 4852 feet to 0 feet for each plug set.

Heavy Mud from 4852 to 750 ft.; plug; 10 sacks cement; heavy mud to 240 ft.; plug; 10 sacks cement; heavy mud to 20 ft.; plug; 5 sacks of cement to surface; plug welden on.

(If additional description is necessary, use BACK of this sheet)

Name of Plugging Contractor Watson Drilling Co., Inc
Address 528 State Bank Bldg., Winfield, Kansas

STATE OF Kansas, COUNTY OF Cowley, ss.
Ben Gralapp, one of operators _____ (employee of owner) or (owner or operator) of the above-described well, being first duly sworn on oath, says: That I have knowledge of the facts, statements, and matters herein contained and the log of the above-described well as filed and that the same are true and correct. So help me God.

(Signature) Ben Gralapp
P.O. Box 719 Winfield Kans
(Address)

SUBSCRIBED AND SWORN to before me this 15 day of May, 19 59

My commission expires April 9, 1961

Grace Hill
Notary Public.

PLUGGING
FILE SEC 1 T. 34 R. 15W
BOOK PAGE 22 LINE 5

RECEIVED
STATE CORPORATION COMMISSION

MAY 16 1959

CONSERVATION DIVISION
Wichita, Kansas

WELL LOG

Company: Gralapp & Everly
Winfield, Kansas

Contractor: Watson Drilling Co., Inc.
Winfield, Kansas

Commence: 4/21/59
Complete: 5/11/59

MURDOCK #1 #1
Cor. SW 34 1-34S-15W
Barber County, Kansas.

Casing Record:
774 ft. of 8 5/8" surface
set @ ft. w/ 550 sacks
cement.

DRY & PLUGGED

SURFACE soil & red bed	0	298
red bed	292	774
shale	774	1695
shale & lime	1695	1900
shale	1900	1990
shale & lime	1990	1995
lime	1995	2427
shale	2427	2528
shale & lime	2528	2689
shale	2689	2700
shale & sand streaks	2700	2760
broken lime & shells	2760	3074
lime & shale	3074	3185
shale & lime	3185	3200
lime	3200	3358
shale & sand streaks	3358	3450
lime	3450	3473
shale & lime	3473	3608
shale	3608	3885
shale & sand	3885	3995
lime & shale	3995	4029
sand	4029	4070
lime & shale	4070	4129
lime	4129	4175
shale & lime	4175	4184
lime	4184	4656
lime & shale	4656	4678
lime	4678	4852

T. D. Rotary 4852'

STATE OF KANSAS, COUNTY OF CONLEY, SS:

I hereby certify that the above is a true and correct copy of Well Log made by me from the Daily Drilling Report of Watson Drilling Company, Inc., this 14th day of May, 1959.

Grace Hill
Grace Hill Notary Public

My commission expires:

April 9, 1961

PLUGGING
FILE SEC. 1 T. 34 R. 15W
BOOK PAGE 39 LINE 25

MAY 16 1959

DIVISION
Kansas