


STATE OF KANSAS  
STATE CORPORATION COMMISSION  
CONSERVATION DIVISION  
P. O. BOX 17027  
WICHITA, KANSAS 67217

FORM CP-4

WELL PLUGGING RECORD

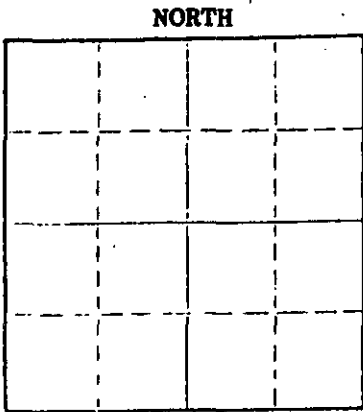

Locate well correctly on above Section Plot

Harper County, Sec. 6 Twp. 32S Rge. 7W (E) (W)  
Location as "NE/CNW&SWX" or footage from lines SW NW NW  
Lease Owner Okmar Oil Company  
Lease Name Nancy Well No. 1  
Office Address 970 Fourth Financial Center, Wichita, Kansas  
Character of Well (completed as Oil, Gas or Dry Hole) Dry hole  
Date well completed May 20 19 77  
Application for plugging filed May 20 19 77  
Application for plugging approved May 20 19 77  
Plugging commenced May 20 19 77  
Plugging completed May 20 19 77  
Reason for abandonment of well or producing formation Dry hole

If a producing well is abandoned, date of last production \_\_\_\_\_ 19 \_\_\_\_  
Was permission obtained from the Conservation Division or its agents before plugging was commenced? Yes, verbally

Name of Conservation Agent who supervised plugging of this well Duane Rankin  
Producing formation \_\_\_\_\_ Depth to top \_\_\_\_\_ Bottom \_\_\_\_\_ Total Depth of Well 4750 Feet  
Show depth and thickness of all water, oil and gas formations.

OIL, GAS OR WATER RECORDS

CASING RECORD

FORMATION	CONTENT	FROM	TO	SIZE	PUT IN	PULLED OUT
				8-5/8"	262	

Describe in detail the manner in which the well was plugged, indicating where the mud fluid was placed and the method or methods used in introducing it into the hole. If cement or other plugs were used, state the character of same and depth placed, from \_\_\_\_\_ feet to \_\_\_\_\_ feet for each plug set.

1st plug at 240 with 35 sacks  
2nd plug at 40 with 15 sacks, 5 sacks in rathole

RECEIVED  
STATE CORPORATION COMMISSION  
JUL 05 1977  
CONSERVATION DIVISION  
Wichita, Kansas

(If additional description is necessary, use BACK of this sheet)  
Name of Plugging Contractor Union Drilling Co., Inc.  
Address 505 Union Center, Wichita, Kansas 67202

STATE OF KANSAS COUNTY OF SEDGWICK, ss.  
R. D. Messinger

(employee of owner) or (owner or operator) of the above-described well, being first duly sworn on oath, says: That I have knowledge of the facts, statements, and matters herein contained and the log of the above-described well as filed and that the same are true and correct. So help me God.

(Signature) R. D. Messinger  
505 Union Center, Wichita, Kansas  
(Address)

Subscribed and Sworn to before me this 24th day of May, 19 77

My commission expires July 29, 1978  
Donna F. Brown Notary Public.

*well log*

CONTRACTOR'S WELL LOG

OPERATOR:	Okmar Oil Company
CONTRACTOR:	Union Drilling Co., Inc.
WELL NAME:	Nancy #1
LOCATION:	SW NW NW Section 6-32S-7W Harper County, Kansas
COMMENCED:	May 5, 1977
COMPLETED:	May 20, 1977

0	265	Shale and sand	8-5/8" casing set at 262 w/175 sacks
265	1210	Shale	
1210	1517	Shale and shells	
1517	1716	Shale	
1716	2083	Lime and shale	
2083	2239	Shale and lime	
2239	2700	Lime and shale	
2700	2790	Lime	
2790	2860	Lime and shale	
2860	2921	Lime	
2921	3021	Lime and shale	
3021	3140	Lime	
3140	3312	Lime and shale	
3312	3425	Shale and lime	
3425	3517	Lime	
3517	3777	Lime and shale	
3777	3833	Lime	
3833	3935	Lime and shale	
3935	4115	Lime	
4115	4192	Lime and shale	
4192	4349	Lime	
4349	4640	Lime and shale	
4640	4723	Lime	
4723	4750	Lime and shale	
4750		T. D.	

RECEIVED  
STATE CORPORATION COMMISSION  
JUL 05 1977  
CONSERVATION DIVISION  
Wichita, Kansas

We certify that the above and foregoing is a true and correct copy of the log of the Nancy #1, SW NW NW Section 6-32S-7W, Harper County, Kansas.

UNION DRILLING CO., INC.

*R. D. Messinger*  
R. D. Messinger

STATE OF KANSAS )  
                          ) SS  
COUNTY OF SEDGWICK )

Subscribed and sworn to before me, a Notary Public in and for the aforesaid county and state as of this 24th day of May, 1977.

*Donna F. Brown*  
Donna F. Brown, Notary Public

My commission expires: 7-29-78