


WELL PLUGGING RECORD

Give All Information Completely
Make Required Affidavit
Mail or Deliver Report to:
Conservation Division
State Corporation Commission
212 North Market, Insurance Bldg.
Wichita, Kansas

Harper County. Sec. 6 Twp. 32 Rge. (E) 7 (W)

Location as "NE/CNW½SW¼" or footage from lines NE NE NE
Lease Owner Aylward Drilling Company
Lease Name Stelle Parker Well No. 1
Office Address 813 1st Nat'l Bank Bldg. - Wichita 2, Kansas
Character of Well (completed as Oil, Gas or Dry Hole) Dry Hole
Date well completed September 29 1959
Application for plugging filed September 29 1959
Application for plugging approved September 29 1959
Plugging commenced September 29 1959
Plugging completed September 29 1959
Reason for abandonment of well or producing formation

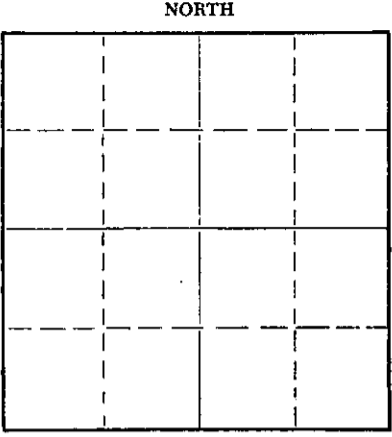

Locate well correctly on above Section Plat

If a producing well is abandoned, date of last production 19
Was permission obtained from the Conservation Division or its agents before plugging was commenced? Yes

Name of Conservation Agent who supervised plugging of this well Fred Hample
Producing formation None Depth to top Bottom Total Depth of Well 4770 Feet
Show depth and thickness of all water, oil and gas formations.

OIL, GAS OR WATER RECORDS

CASING RECORD

FORMATION	CONTENT	FROM	TO	SIZE	PUT IN	PULLED OUT
				8 5/8"	214'	None

Describe in detail the manner in which the well was plugged, indicating where the mud fluid was placed and the method or methods used in introducing it into the hole. If cement or other plugs were used, state the character of same and depth placed, from feet to feet for each plug set.

Plugged hole with heavy mud to 210', set plug at 210' with 18 sacks cement and 1/4 sack hulls. Heavy mud to 40', set plug at 40' with 10 sacks cement and 1/4 sack hulls. Bridged rathole with 2 sacks cement.

RECEIVED
COMMISSION
JAN 21 1960
CONSERVATION DIVISION
Wichita, Kansas

(If additional description is necessary, use BACK of this sheet)
Name of Plugging Contractor Aylward Drilling Company
Address 813 1st National Bank Bldg. - Wichita 2, Kansas

STATE OF Kansas COUNTY OF Sedgwick ss.
Charles D. Williams (employee of owner) or (owner or operator) of the above-described well, being first duly sworn on oath, says: That I have knowledge of the facts, statements, and matters herein contained and the log of the above-described well as filed and that the same are true and correct. So help me God.

(Signature) Charles D. Williams
813 1st Nat'l Bank Bldg. - Wichita 2, Kansas
(Address)

SUBSCRIBED AND SWORN to before me this 2nd day of October, 1959

My commission expires December 11, 1961
DUANE JESSUP Notary Public.

R
PARKER NO. 1

Casing Record:
8 5/8" - 214'

Company: Aylward Drilling Company et al
Contractor: Aylward Drilling Company
Commenced: September 14, 1959
Completed: September 29, 1959

Location: NE NE NE 6-32-7W
Harper County
Kansas
Elevation: 1469 K.B.

	<u>From</u>	<u>To</u>	<u>Remarks</u>
Clay & Sand	0	40	Set 8 5/8" surface pipe @ 214' w/175 sacks cement.
Red Rock & Sand	40	115	
Red Rock & Sandy Streaks	115	215	Geological Tops: Topeka 2950 Elgin 3130 Douglas 3415 Stalnaker 3689 Kansas City 3844 Mississippian 4387 Kinderhook 4624 Viola 4726 Simpson 4763 DST 4382-4407 Open 1 hr. Good blow. Gas to surf. in 50". Rec. 120' HGCM & Spots oil, 290' GCMW w/spots oil. IBHP 175# - FBHP 1445#. FP 75#-390#. DST 4763-70 Open 1 hr. Good blow. Rec. 160' GCM & 3,590' GCSW. IBHP 1825# - FBHP 1820#. FP 205#-1695#. D & A
Red Rock, Red Bed & Shale	215	550	
Shale	550	750	
Anhydrite	750	765	
Shale	765	1105	
Shale & Shells	1105	1160	
Salt	1160	1200	
Lime & Shale	1200	1355	
Lime w/Shale	1355	1610	
Lime	1610	1870	
Lime & Shale	1870	2355	
Shale & Lime	2355	2876	
Lime & Shale	2876	3235	
Shale & Lime	3235	3650	
Shale & Sand	3650	3710	
Shale	3710	3857	
Lime	3857	4070	
Lime & Shale	4070	4096	
Shale & Lime	4096	4146	
Lime & Shale	4146	4325	
Shale & Lime	4325	4387	
Lime	4387	4595	
Lime & Shale	4595	4623	
Shale	4623	4633	
Shale w/Lime	4633	4674	
Shale & Lime	4674	4726	
Lime & Shale	4726	4770 T.D.	

RECEIVED
STATE CORPORATION COMMISSION
JAN 21 1960
CONSERVATION DIVISION
Wichita, Kansas

I hereby certify that this is a true and correct copy of the above log to the best of my knowledge.

Charles D. Williams

Subscribed and sworn to before me this 1st day of October, 1959.

Duane Jessup
_____ Notary Public
DUANE JESSUP

My commission expires December 11, 1961