


STATE OF KANSAS
STATE CORPORATION COMMISSION

WELL PLUGGING RECORD

Give All Information Completely
Make Required Affidavit
Mail or Deliver Report to:
Conservation Division
State Corporation Commission
212 No. Market
Wichita, Kansas 67202

Harper County, Sec. 5 Twp. 325 Rge. (E) 7 (W)
Location as "NE/CNW/SW" or footage from lines N. W. N. W. S. E.
Lease Owner Stephen A. Jernigan
Lease Name Fulton Well No. 1
Office Address 1118 Colcord Bldg. Oklahoma City, Okla
Character of Well (completed as Oil, Gas or Dry Hole) Dry hole
Date well completed Jan. 1 1970
Application for plugging filed Jan. 5 1970
Application for plugging approved Jan. 5 1970
Plugging commenced Jan. 1 1970
Plugging completed Jan. 1 1970
Reason for abandonment of well or producing formation Dry hole

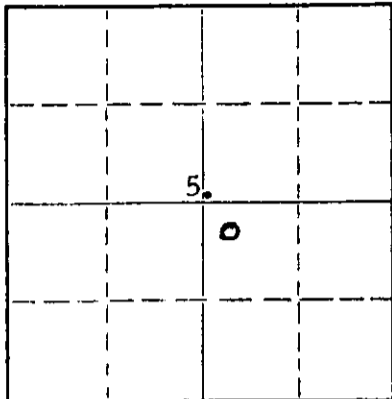

Locate well correctly on above
Section Plat

If a producing well is abandoned, date of last production 19
Was permission obtained from the Conservation Division or its agents before plugging was commenced? Yes

Name of Conservation Agent who supervised plugging of this well Herman Justus
Producing formation Wilcox Depth to top Bottom 4805 Total Depth of Well 4805 Feet
Show depth and thickness of all water, oil and gas formations.

OIL, GAS OR WATER RECORDS

CASING RECORD

| FORMATION | CONTENT | FROM | TO | SIZE | PUT IN | PULLED OUT |
|------------------|---------|------|------|-------|--------|------------|
| Kansas City | Water | 3839 | 4050 | 8 5/8 | 252 | none |
| Mississippi | Water | 4393 | 4638 | | | |
| Simpson (Wilcox) | Water | 4785 | 4805 | | | |
| | | | | | | |
| | | | | | | |
| | | | | | | |
| | | | | | | |

Describe in detail the manner in which the well was plugged, indicating where the mud fluid was placed and the method or methods used in introducing it into the hole. If cement or other plugs were used, state the character of same and depth placed, from feet to feet for each plug set.

25 sax regular cement spotted in surface pipe. Base cement plug at 240' then 10 sax cement spotted at 30', all inside 8 5/8" surface pipe. 5 sax cement used to fill rat hole

RECEIVED
STATE CORPORATION COMMISSION
JAN 9 1970
CONSERVATION DIVISION
Wichita, Kansas

(If additional description is necessary, use BACK of this sheet)
Name of Plugging Contractor Thomas Drlg. Co. and Halliburton
Address Duncan, Oklahoma

STATE OF Oklahoma, COUNTY OF Oklahoma, ss.
Stephen A. Jernigan (employee of owner) or (owner or operator) of the above-described well, being first duly sworn on oath, says: That I have knowledge of the facts, statements, and matters herein contained and the log of the above-described well as filed and that the same are true and correct. So help me God.

(Signature) Stephen A. Jernigan
1118 Colcord Bldg., Okla City, Okla
(Address)

SUBSCRIBED AND SWORN TO before me this 7 day of Jan, 1970

My commission expires 1-30-73

[Signature]
Notary Public.

DRILLERS LOG

| | |
|--------------------|--|
| Company | Jernigan Oil |
| Contractor | Thomas Drilling Co. |
| Lease Name | Fulton #1 |
| Location | NW NW SE 5-32S-7W, Harper Co., Kansas |
| Elevation | 1451' KB |
| Surface Casing | 9Jts. (252') 8-5/8" |
| Commenced | Dec. 20, 1969 |
| Completed | Jan. 1, 1970 |
| Rotary Total Depth | 4805' |

| FORMATION | DEPTH |
|-----------------------|-------|
| Surface sand & clay | 274 |
| shale | 570 |
| lime & shale | 1030 |
| lime | 1038 |
| Sandy lime | 1202 |
| Bkn. sandy lime & sh. | 1550 |
| limey sand | 1720 |
| sand-broken | 2310 |
| Sand | 2350 |
| shale | 2510 |
| lime | 2706 |
| shale | 2730 |
| sand | 2798 |
| shale | 3000 |
| sand | 3080 |
| shale | 3200 |
| sand | 3430 |
| shale | 3460 |
| sand | 2488 |
| shale | 3640 |
| sand | 3780 |
| shale | 3840 |
| lime | 4330 |
| shale | 4396 |
| lime | 4640 |
| shale | 4766 |
| Simpson (top) | 4766 |
| dolomite | 4793 |
| Sand | 4815 |

DST #1 4398-4409
Ran Electric Log.
D & A Plugged 1-1-70

RECEIVED
STATE CORPORATION COMMISSION
JAN 23 1970
CONSERVATION DIVISION
Wichita, Kansas

State of Oklahoma) SS:
County of Oklahoma)

The undersigned, being duly sworn on oath, states that the above statement and log are a true and correct log of the well drilled at the location above described

Stephen A. Jernigan
Stephen A. Jernigan, AFFIANT

Subscribed and sworn to before me this 22 day of January, 1970.

Meda M. Wise
Notary Public

My Commission expires:

Feb. 6, 1972