


STATE OF KANSAS
STATE CORPORATION COMMISSION
CONSERVATION DIVISION
P. O. BOX 17027
WICHITA, KANSAS 67217

WELL PLUGGING RECORD

Harper County, Sec. 1 Twp 32S Rge. (E) 8 (W)
Location as "NE/CNWKSW" or footage from lines 1830' FNL & 510' FWL
Lease Owner Texas Oil & Gas Corp.
Lease Name Flowers Well No. 1
Office Address 200 W. Douglas, Suite 450 Wichita KS 67202
Character of Well (completed as Oil, Gas or Dry Hole) Dry hole
Date well completed 9-12-76 19
Application for plugging filed 9-12-76 19
Application for plugging approved 9-12-76 19
Plugging commenced 9-12-76 19
Plugging completed 9-12-76 19
Reason for abandonment of well or producing formation

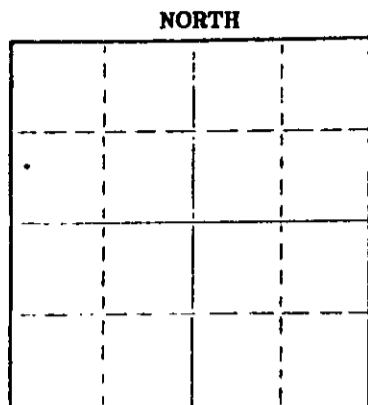

If a producing well is abandoned, date of last production 19
Was permission obtained from the Conservation Division or its agents before plugging was commenced? Yes

Name of Conservation Agent who supervised plugging of this well George Russell Biberstein
Producing formation Depth to top Bottom Total Depth of Well
Show depth and thickness of all water, oil and gas formations.

OIL, GAS OR WATER RECORDS				CASING RECORD		
FORMATION	CONTENT	FROM	TO	SIZE	PUT IN	PULLED OUT
		0	258'	8 5/8"		

Describe in detail the manner in which the well was plugged, indicating where the mud fluid was placed and the method or methods used in introducing it into the hole. If cement or other plugs were used, state the character of same and depth placed, from feet to feet for each plug set.

Heavy mud from T.D. to 240' 35 sack cement plug mud to 40'
1/2 sack hulls plug bridge 15 sack base of cellar 5 sacks rat hole.

RECEIVED
STATE CORPORATION COMMISSION
SEP 17 1976

CONSERVATION DIVISION
WICHITA, KANSAS

Name of Plugging Contractor XPLOR DRILLING CO.
Address 434 N. Market Suite 110 Wichita, KS 67202

STATE OF KANSAS COUNTY OF SEDGWICK

Wayne L. Kirkman (employee of owner) or (owner or operator) of the above-described well, being first duly sworn on oath, says: That I have knowledge of the facts, statements, and matters herein contained and the log of the above-described well as filed and that the same are true and correct. So help me God.

(Signature) [Signature]
434 N. Market Suite 110 Wichita, KS 67202 (Address)

Subscribed and sworn to before me this 14th day of September 1976

My commission expires August 25, 1980 Virginia Lee Smith, Notary Public.



WELL LOG

FLOWERS #1
1830' FNL & 510' FWL
Section 1-32S-8W
Harper County, Kansas

OPERATOR: TEXAS OIL & GAS CORP. COMMENCED: 9-7-76
CONTRACTOR: XPLOR DRILLING CO. COMPLETED: 9-12-76

CASING RECORD: Cut 262' 12 1/4" hole. Ran 6 jts. new 24# 8 5/8" casing set @258'. Cement with 100 sacks Howco light cement, 3% cal.chloride, 150 sacks common 2% gel. 3% cal.chloride.

<u>FORMATION</u>	<u>FROM</u>	<u>TO</u>	<u>ELEVATION</u>
Shale & Red Bed	0	1369	
Shale	1369	1595	
Shale & Lime	1595	2250	
Shale, Lime & Sand	2250	2571	
Shale & Lime	2571	2984	
RTD	2984		

RECEIVED
STATE COMMISSIONER OF CORPORATIONS

SEP 17 1976

CONSERVATION DIVISION
Wichita, Kansas

STATE OF KANSAS)
) SS:
COUNTY OF SEDGWICK)

I certify that this is a true and correct copy of the Driller's Log of the well drilled 1830' FNL & 510' FWL of Section 1-32S-8W, Harper County, Kansas, to the best of my knowledge and belief.

XPLOR DRILLING COMPANY

Wayne L. Kirkman
Wayne L. Kirkman, Owner

Subscribed and sworn to before me this 14th. day of September 1976.

MY COMMISSION EXPIRES:
August 25, 1980

Virginia Lee Smith
Virginia Lee Smith, Notary Public

