

15-077-20791-00-00


STATE OF KANSAS  
STATE CORPORATION COMMISSION

WELL PLUGGING RECORD

Give All Information Completely  
Make Required Affidavit  
Mail or Deliver Report to  
Conservation Division  
State Corporation Comm.  
245 North Water  
Wichita, KS 67202

Harper County, Sec. 19 Twp. 32S Rge. 6W ~~XX~~W  
Location as "NE/CNW $\frac{1}{4}$ /SW $\frac{1}{4}$ " or footage from lines  
C NE NW

Lease Owner Stelbar Oil Corp, Inc.  
Lease Name Thompson Well No. 1  
Office Address 450-4th Financial Center, Wichita, Kansas  
Character of Well (Completed as Oil, Gas or Dry Hole)

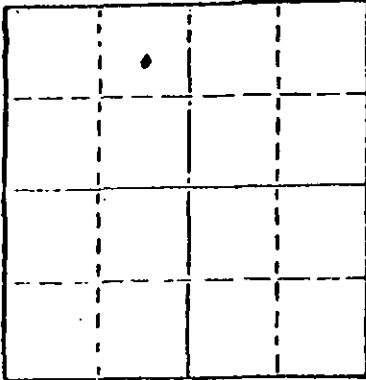

Locate well correctly on above  
Section Plot

Dry Hole  
Date Well completed 4-2 1982  
Application for plugging filed 4-2 1982  
Application for plugging approved 4-2 1982  
Plugging commenced 4-2 1982  
Plugging completed 4-2 1982  
Reason for abandonment of well or producing formation  
Dry Hole

If a producing well is abandoned, date of last production 19

Was permission obtained from the Conservation Division or its agents before plugging was commenced? Yes

Name of Conservation Agent who supervised plugging of this well Maurice Leslie  
Producing formation Depth to top Bottom Total Depth of Well  
Show depth and thickness of all water, oil and gas formations.

OIL, GAS OR WATER RECORDS

CASING RECORD

FORMATION	CONTENT	FROM	TO	SIZE	PUT IN	PULLED OUT
Surface pipe		-0-	259'	8 5/8"	259'	NONE

Describe in detail the manner in which the well was plugged, indicating where the mud fluid was placed and the method or methods used in introducing it into the hold. If cement or other plugs were used, state the character of same and depth placed, from feet to feet for each plug set.

Filled hole with heavy mud.

- #1 Plug set @ 620' with 60 sks. cement.
- #2 Plug set @ 250' with 40 sks. cement.
- #3 Plug set @ 40' with 10 sks. cement.
- #4 Plug set in rat hole with 10 sks. cement.

(If additional description is necessary, use BACK of this sheet)

Name of Plugging Contractor Sweetman Drilling, Inc.

STATE OF Kansas COUNTY OF Barton, ss.  
Gary L. Hawk (employee of owner) or (owner or operator)

of the above-described well, being first duly sworn on oath, says: That I have knowledge of the facts, statements, and matters herein contained and the log of the above-described well as filed and that the same are true and correct. So help me God.

(Signature) Gary L. Hawk  
Box 645, Great Bend, Kansas 67530  
(Address)

SUBSCRIBED AND SWORN TO before me this 13th day of April, 1982

Walter A. Becker  
Notary Public.

My commission expires 9-4-85



RECEIVED  
STATE CORPORATION COMMISSION  
APR 14 1982  
CONSERVATION DIVISION  
Wichita, Kansas

WELL LOG  
Thompson #1  
C NE NW 19-32S-6W  
Harper County, Kansas

Name Of Operator: Stelbar Oil Corp., Inc.  
450 -4th Financial Center  
Wichita, Kansas 67202

Date Completed: April 2, 1982

RECEIVED  
STATE CORPORATION COMMISSION

APR 14 1982


CONSERVATION DIVISION  
Wichita, Kansas

FROM	TO	
0	300	Red Bed
300	1205	Red bed and shale
1205	4456	Lime & shale
4456	4633	Miss.
4633	4848	Lime and shale
4848	4915	Simpson
4915		Total Depth

STATE OF KANSAS

COUNTY OF BARTON ss

Gary L. Hawk, Secretary of Sweetman Drilling, Inc. being first duly sworn on oath says: That I have the knowledge of the facts, statements and matters herein contained and the log of the above described well as filed and that the same are true and correct.

  
Gary L. Hawk

Subscribed and sworn before me this 9th day of April, 1982.

  
Notary Public -Barton County

My Commission Expires: September 4, 1985

