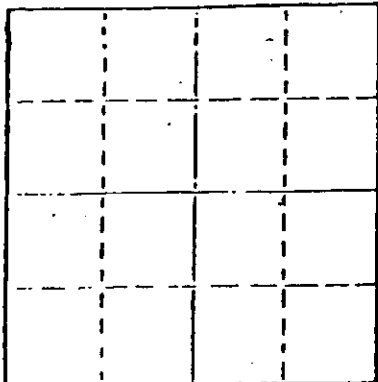


STATE OF KANSAS  
STATE CORPORATION COMMISSION

## WELL PLUGGING RECORD

Give All Information Completely  
Make Required Affidavit  
Mail or Deliver Report to  
Conservation Division  
State Corporation Comm.  
245 North Water  
Wichita, KS 67202

Locate well correctly on above  
Section Plat

Harper County. Sec. 14 Twp. 34S Rge. 9 E/W  
Location as "NE/CNW/SW" or footage from lines  
NW NE

Lease Owner Mull Drilling Co., Inc.  
Lease Name Warner Well No. 1  
Office Address 221 N. Main, Suite 300, Wichita, Kansas 67202  
Character of Well (Completed as Oil, Gas or Dry Hole) Dry Hole

Date Well completed 2-12 1982  
Application for plugging filed 2-12 1982  
Application for plugging approved 2-12 1982  
Plugging commenced 2-12 1982  
Plugging completed 2-12 1982  
Reason for abandonment of well or producing formation

Dry Hole  
If a producing well is abandoned, date of last production 19

Was permission obtained from the Conservation Division or  
its agents before plugging was commenced? Yes

Name of Conservation Agent who supervised plugging of this well Maurice Leslie  
Producing formation Depth to top Bottom Total Depth of Well 4670  
Show depth and thickness of all water, oil and gas formations.

## OIL, GAS OR WATER RECORDS

## CASING RECORD

FORMATION	CONTENT	FROM	TO	SIZE	PUT IN	PULLED OUT
				8-5/8	290	0

Describe in detail the manner in which the well was plugged, indicating where the mud fluid  
was placed and the method or methods used in introducing it into the hold. If cement or other  
plugs were used, state the character of same and depth placed, from feet to  
feet for each plug set.

Mud to 550', Dry Hole Plug, 60 sx cement  
Mud to 270', Dry Hole Plug, 40 sx cement  
Mud to 40', Dry Hole Plug, 10 sx cement  
Bridged rat hole w/10 sx cement

(If additional description is necessary, use BACK of this sheet)

Name of Plugging Contractor Range Drilling Company, Inc.

STATE OF Kansas COUNTY OF Sedgwick, ss.  
Gary L. Reed (employee of owner) or (owner or operator)  
of the above-described well, being first duly sworn on oath, says: That I have knowledge of  
the facts, statements, and matters herein contained and the log of the above-described well  
as filed and that the same are true and correct. So help me God.


(Signature)

240 Page Court, 220 W. Douglas, Wichita, Kansas  
(Address)

SUBSCRIBED AND SWORN TO before me this 22nd day of February, 1982

Nora S. Davidson  
Notary Public.

My commission expires

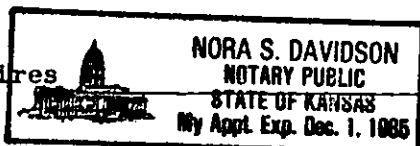

Well Log  
#1 Warner  
NW NE  
Section 14-34S-9W  
Harper County, Kansas

Operator: Mull Drilling Co., Inc.  
221 N. Main, Suite 300  
Wichita, Kansas 67202


Casing Record: 8-5/8" @ 290' W/250 sx cement

Date Completed: February 12, 1982

<u>From</u>	<u>To</u>	
0	895	Shale
895	1755	Shale w/lime
1755	2010	Shale
2010	2150	Lime w/shale
2150	2240	Sand/shale
2240	2502	Shale
2502	2750	Shale and lime
2750	2972	Shale, sand, lime
2972	3080	Shale
3080	3689	Lime and shale
3689	3860	Shale
3860	4040	Lime and shale
4040	4227	Shale/lime
4227	4499	Lime and shale
4499	4525	Lime
4525	4580	Lime/shale
4580	4590	Mississippi
4590	4618	Lime/shale
4618	4670	Lime
4670		TD

State of Kansas  
County of Sedgwick

Gary L. Reed, Vice President of Range Drilling Company, Inc., being first duly sworn on oath, says: That I have knowledge of the facts, statements, and matters herein contained and the log of the above-described well as filed and that the same are true and correct.

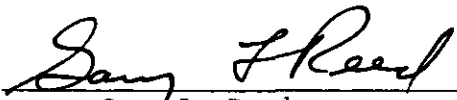  
\_\_\_\_\_  
Gary L. Reed

SUBSCRIBED AND SWORN To before me this 22<sup>nd</sup> day of February, 1982

  
\_\_\_\_\_  
Notary Public

My commission expires

