


WELL PLUGGING RECORD

Give All Information Completely  
Make Required Affidavit  
Mail or Deliver Report to:  
Conservation Division  
State Corporation Commission  
800 Bitting Building  
Wichita, Kansas

NORTH

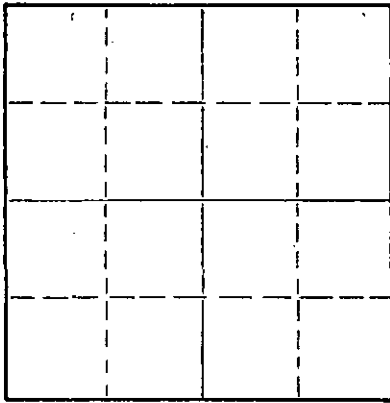

Locate well correctly on above  
Section Plat

Harper County, Sec 11 Twp. 34 Rge. (E) 9 (W)  
Location as "NE/CNW\*SW\*" or footage from lines SW SW SW  
Lease Owner Continental Oil Co.  
Lease Name M. Minzer Well No. 1  
Office Address Box 161, Great Bend, Kansas  
Character of Well (completed as Oil, Gas or Dry Hole) Dry Hole  
Date well completed 7-1 1955  
Application for plugging filed 7-1 1955  
Application for plugging approved 7-1 1955  
Plugging commenced 7-1 1955  
Plugging completed 7-1 1955  
Reason for abandonment of well or producing formation No commercial zones encountered.  
If a producing well is abandoned, date of last production 19  
Was permission obtained from the Conservation Division or its agents before plugging was commenced? Yes

Name of Conservation Agent who supervised plugging of this well M.A. Rives  
Producing formation None Depth to top Bottom Total Depth of Well 5225 Feet  
Show depth and thickness of all water, oil and gas formations.

OIL, GAS OR WATER RECORDS

set at CASING RECORD

FORMATION	CONTENT	FROM	TO	SIZE	<del>XXXXXX</del>	PULLED OUT
Mississippi	Water	4648	4680	10 3/4	253	
				5 1/2	4750	4120

Describe in detail the manner in which the well was plugged, indicating where the mud fluid was placed and the method or methods used in introducing it into the hole. If cement or other plugs were used, state the character of same and depth placed, from feet to feet for each plug set.  
Pulled 4120' of 5 1/2" OD casing, set plug at 250' in 10 3/4" OD casing. Pumped 35 sacks cement on top of plug. Filled pipe with mud to 25'. Set plug at 25' and cemented to surface with 15 sacks cement.

RECEIVED  
STATE CORPORATION COMMISSION  
JUL 9 1955  
CONSERVATION DIVISION  
WICHITA, KANSAS  
7-9-55

(If additional description is necessary, use BACK of this sheet)  
Name of Plugging Contractor G-M-R Drilling Co.  
Address Box 1033, Wichita, Kansas

STATE OF Kansas, COUNTY OF Barton, ss.  
F.L. Dunn (employee of owner) or (owner or operator) of the above-described well, being first duly sworn on oath, says: That I have knowledge of the facts, statements, and matters herein contained and the log of the above-described well as filed and that the same are true and correct. So help me God.

ARC  
7-6-55  
State RFD File  
(Signature) F.L. Dunn  
Box 161, Great Bend, Kansas  
(Address)

SUBSCRIBED AND SWORN TO before me this 6th day of July, 1955

My commission expires July 31, 1958  
D. E. Jones  
Notary Public.

PLUGGING  
FILE SEC-11T-34-R-26  
BOOK PAGE 131 LINE 19

NO. 1 N. MINTER

WELL RECORD

Location: SW SW SW, 11-34S-9W  
Harper County, Kansas

Commenced: June 1, 1955

Operator: Continental Oil Company  
135 West Lewis, Wichita, Kansas

Completed: June 30, 1955

Elevation: 1310 M

Contractor: Graham-Messman-Minehart Drilling Co.  
1005 East Second, Wichita, Kansas

Production: D&A

Casing Record: 10 3/4" @ 253' w/225 sacks cement  
5 1/2" @ 4750' w/100 sacks cement

.....L O O.....

Surface soil-Clay	160	Line-Sand	5100
Red Bed	260	Sand-Shale	5126
Red Bed-Shale	1075	Line	5163
Shale-Shells	1330	and-Chert	5250
Shale-Line	1232	Line	5225 R.T.D.
Line-Shale	2218		
Shale-Line	2695		
Line-Shale	3055		
Shale-Line	3190		
Line-Shale	3297		
Shale-Line	3450		
Line-Shale	3703		
Shale-Line	3890		
Line-Shale	3950		
Line	4070		
Shale-Line	4120		
Line	4265		
Line-Shale	4325		
Line	4491		
Line-Shale-Chert	4513		
Line	4601		
Chert-Line	4615		
Line	4630		
Chert-Line	4678		
Line	4699		
Mississippi	4723		
Chert-Line	4747		
Line	4965		
Chert-Line	4985		
Line-Chert	5021		
Line	5025		
Simpson	5052		

The undersigned, GRAHAM-MESSMAN-MINEHART DRILLING COMPANY, hereby certifies that the above log is a true and correct log of the formation encountered in drilling the above well as reflected by the daily drilling report.

GRAHAM-MESSMAN-MINEHART DRILLING COMPANY

By: \_\_\_\_\_

*J. A. Gilliland*  
J. A. Gilliland

Subscribed and sworn to before me on this 13th day of July 1955.

*Juanita L. Lewis*  
Notary Public

My Commission Expires: November 1, 1955

SCC RFD SRC FLD

JUL 13 1955

CONSERVATION DEPARTMENT  
**PLUGGING**  
FILE SEC-11-T-34-R-9W  
BOOK PAGE 31 LINE 19