


WELL PLUGGING RECORD

Give All Information Completely
Make Required Affidavit
Mail or Deliver Report to:
Conservation Division
State Corporation Commission
211 No. Broadway
Wichita, Kansas

HARPER

County. Sec. 14 Twp. 31 Rge. 9 (E) (W) X

Location as "NE/CNW/SW" or footage from lines SE SE
Lease Owner Wichita Iron & Metals Corp., Inc.
Lease Name MORRIS Well No. 1
Office Address Box 2421, Wichita, Kansas
Character of Well (completed as Oil, Gas or Dry Hole) Oil
Date well completed July 23, 1954
Application for plugging filed August 16, 1962
Application for plugging approved August 21, 1962
Plugging commenced August 27, 1962
Plugging completed August 30, 1962
Reason for abandonment of well or producing formation
Depleted - operated at a loss.

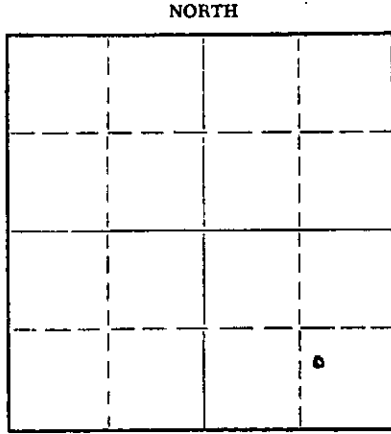

Locate well correctly on above Section Plat

If a producing well is abandoned, date of last production _____ 19____
Was permission obtained from the Conservation Division or its agents before plugging was commenced? Yes

Name of Conservation Agent who supervised plugging of this well Herman Justice
Producing formation Mississippi Depth to top 4403 Bottom 4500 Total Depth of Well 4500 Feet
Show depth and thickness of all water, oil and gas formations.

OIL, GAS OR WATER RECORDS

CASING RECORD

FORMATION	CONTENT	FROM	TO	SIZE	PUT IN	PULLED OUT
Douglas	water	3526	3629	8-5/8 OD	157'	None
Lansing	water	3639	3807	5-1/2	4500'	3225'
Mississippi	Oil & Gas	4403	4500			

Describe in detail the manner in which the well was plugged, indicating where the mud fluid was placed and the method or methods used in introducing it into the hole. If cement or other plugs were used, state the character of same and depth placed, from _____ feet to _____ feet for each plug set.

Cleaning out cellar, rigging up filled with sand from 4500' to 4450', run 5 sacks of cement from 4450' to 4420'.
Mudded from 4420' to 157' rock bridge 157' to 150', run 20 sacks of cement from 150' to 90' mudded from 90' to 40' rock and 10 sacks of cement from 40' to base of cellar. Took up 2" gas line.

RECEIVED
STATE CORPORATION COMMISSION
OCT. 11 1962 10-11-62
CONSERVATION DIVISION
Wichita, Kansas

(If additional description is necessary, use BACK of this sheet)
Name of Plugging Contractor Glenn & Smith
Address Ellinwood, Kansas

STATE OF Kansas COUNTY OF Sedgwick
Ray Stekoll, d/b/a Wichita Iron & Metals Corp., Inc., ss.
(employee or owner) or (owner or operator) of the above-described well, being first duly sworn on oath, says: That I have knowledge of the facts, statements, and matters herein contained and the log of the above-described well as filed and that the same are true and correct. So help me God, Wichita Iron & Metals Corp., Inc.

(Signature) By Ray Stekoll
Ray Stekoll Box 2421, Wichita, Kansas
(Address)

SUBSCRIBED AND SWORN TO before me this 10th day of October, 1962

My commission expires Dec 22, 1962
Evelyn V. North
Notary Public.

14

RECEIVED
STATE CORPORATION COMMISSION

OCT 15 1962

CONSERVATION DIVISION
Wichita, Kansas

S. A. BERWICK DRILLING CO. AND AURORA
1105 Williams
Great Bend, Kansas

S. Morris No. 1

SE SE SE Sec. 14-31S-9W
Harper County, Kansas

Total Depth: 4500'

Elevation:

Commenced R. D. : 7-6-54

Initial Prod.:

Completed R. D. : 7-23-54

Contractor: S. A. Berwick
Drilling Company

Strata	Depth
Surface Soil and Sand	0- 15
Red Bed and Shale	15- 157
Red Bed	157- 445
Shale and Shells	445-1200
Shale and Lime	1200-2515
Shale	2515-2905
Shale and Lime	2905-3557
Sandy Lime	3557-3634
Lime	3634-3880
Shale and Lime	3880-4015
Lime	4015-4500

I hereby certify the above a true and correct log of said well as reflected by the daily drilling report.

S. A. BERWICK DRILLING COMPANY

By S. A. Berwick
S. A. Berwick Owner

Signed and sworn to in my presence this 4 day of August, 1954, by S. A. Berwick owner of the S. A. Berwick Drilling Company.

John W. [Signature]
Notary Public

My Commission Expires: April 11, 1955