


WELL PLUGGING RECORD

Give All Information Completely
Make Required Affidavit
Mail or Deliver Report to:
Conservation Division
State Corporation Commission
211 No. Broadway
Wichita, Kansas

NORTH

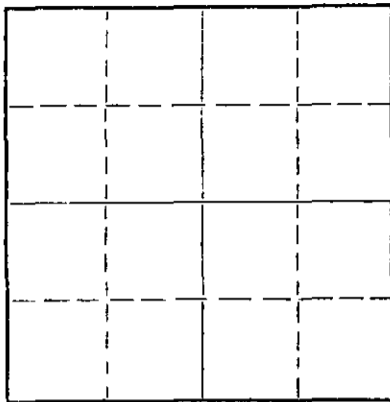

Locate well correctly on above
Section Plat

Harper County, Sec. 14 Twp. 31S Rge. 9 (W) (W)
Location as "NE/CNW&SW¼" or footage from lines SE/SW/SE
Lease Owner Aurora Gasoline Company
Lease Name Morris Well No. #2
Office Address 1107 Un. Natl. Bldg. Wichita, Kansas
Character of Well (completed as Oil, Gas or Dry Hole)
Date well completed 19
Application for plugging filed Yes 19
Application for plugging approved Yes 19
Plugging commenced 7-22 19 58
Plugging completed 7-26 19 58
Reason for abandonment of well or producing formation

If a producing well is abandoned, date of last production 19
Was permission obtained from the Conservation Division or its agents before plugging was commenced? Yes

Name of Conservation Agent who supervised plugging of this well Mr. Fred Hampel
Producing formation Depth to top Bottom Total Depth of Well 4470' Feet
Show depth and thickness of all water, oil and gas formations.

OIL, GAS OR WATER RECORDS

CASING RECORD

FORMATION	CONTENT	FROM	TO	SIZE	PUT IN	PULLED OUT
				8 5/8"	surface	
				5 1/2"		3,786'

Describe in detail the manner in which the well was plugged, indicating where the mud fluid was placed and the method or methods used in introducing it into the hole. If cement or other plugs were used, state the character of same and depth placed, from feet to feet for each plug set.

Measured into T.D. 4470'.
Plugging started 7-22-58. Finished 7-26-58.
Plugged off bottom with sand to 4315' and dumped 5 sacks cement.
Shot 5 1/2" casing at 3,786'. Mixed and circulated 40 sacks gel mud.
Pulled pipe out of hole and plugged well as follows: Mudded to 200'.
Set rock bridge and dumped 25 sacks cement. Filled hole with mud to 35'.
Set rock bridge and mixed 15 sacks cement for cap on well. Well completed.

(If additional description is necessary, use BACK of this sheet)
Name of Plugging Contractor J.O. Forbes d/b/a Forbes Casing Pulling Co.
Address Box 221, Great Bend, Kansas

STATE OF Kansas, COUNTY OF Barton, ss.
J.O. Forbes (employee of owner) or (owner or operator) of the above-described well, being first duly sworn on oath, says: That I have knowledge of the facts, statements, and matters herein contained and the log of the above-described well as filed and that the same are true and correct. So help me God.

(Signature) J.O. Forbes
Box 221, Great Bend, Kans.
(Address)

SUBSCRIBED AND SWORN to before me this 5th day of August, 1958

My commission expires November 8, 1960.

Betty S. Edwards
Notary Public.

AUG 7 1958

PLUGGING CONSERVATION DIVISION
FILE SEC. 14 T. 31 R. 9 W.
BOOK PAGE 117 LINE 20

Wichita, Kansas

WELL LOG BUREAU—KANSAS GEOLOGICAL SOCIETY
503 East Murdock, Wichita, Kansas


COPY

Company- AURORA GASOLINE
Farm- Morris No. 2

SEC. 11, T. 31 R. 9W
SE SW SE

Total Depth. 4470'
Comm. 11-10-54 Comp. 11-24-54
Shot or Traced.
Contractor. S.A. Berwick
Issued. 11-10-56

County Harper
KANSAS

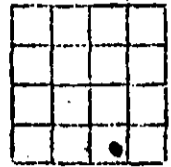

Elevation. 1600' RB

Production. 256 BOPD

CASING:

8" 160'
5" 4470'

Figures indicate Bottom of Formations

clay-sand	45
red rock-shale	100
shale	160
shale-shells	450
shale-shells-red bed	1195
lime	1220
shale-shells	1700
shale-lime	2020
shale-shells	2280
shale	2620
shale-shells	2899
shale-lime	3592
shale	3581
sand	3598
shale-lime	3780
lime	4355
Mississippi chat	4366
lime	4470
Total Depth	

TOPS: Scout	
Anhydrite	1195
Hebner	3423
Lansing	3615
Mississippi	4343

RECEIVED
STATE CORPORATION COMMISSION
SEP 20 1962
CONSERVATION DIVISION
Wichita, Kansas