


WELL PLUGGING RECORD

Give All Information Completely
Make Required Affidavit
Mail or Deliver Report to:
Conservation Division
State Corporation Commission
212 No. Market
Wichita, Kansas

NORTH

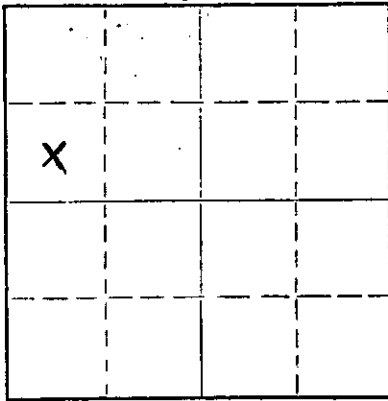

Locate well correctly on above
Section Plat

Edwards County. Sec. 20 Twp 26S Rge 18W (E) W (W)
Location as "NE/CNW/SW" or footage from lines C SW NW
Lease Owner Glen Rupe
Lease Name Case Well No. #2
Office Address 222 Brown Building Wichita, Kansas
Character of Well (completed as Oil, Gas or Dry Hole) Oil
Date well completed _____ 19____
Application for plugging filed May 20 1969
Application for plugging approved May 23 1969
Plugging commenced May 23 1969
Plugging completed 1:30 P. M. May 29 1969
Reason for abandonment of well or producing formation _____

If a producing well is abandoned, date of last production _____ 19____
Was permission obtained from the Conservation Division or its agents before plugging was commenced? Yes

Name of Conservation Agent who supervised plugging of this well Ralph Warren
Producing formation _____ Depth to top _____ Bottom _____ Total Depth of Well _____ Feet
Show depth and thickness of all water, oil and gas formations.

OIL, GAS OR WATER RECORDS

CASING RECORD

FORMATION	CONTENT	FROM	TO	SIZE	PUT IN	PULLED OUT
				8 5/8	289	None
				5 1/2	4484	2886

Describe in detail the manner in which the well was plugged, indicating where the mud fluid was placed and the method or methods used in introducing it into the hole. If cement or other plugs were used, state the character of same and depth placed, from _____ feet to _____ feet for each plug set.

5 - 23 - 69 Dumped sand to 3350'. Mixed and dumped 5 sx of cement from 3350' to 3310'.
5 - 29 - 69 Globe Oil Well Cementing Co., mixed and pumped 10 sx of gel. Released plug and mixed and pumped 75 sx of cement.
250 final pressure
Job completed 5 - 29 - 69 1:30 P. M.


RECEIVED
STATE CORPORATION COMMISSION
JUN 5 1969
CONSERVATION DIVISION
Wichita, Kansas

(If additional description is necessary, use BACK of this sheet)
Name of Plugging Contractor Russ Casing Pulling, Inc.
Address P. O. Box 1082 Great Bend, Kansas 67530

STATE OF Kansas, COUNTY OF Barton, ss.
Russell D. Sullivan (employee of owner) or (owner or operator) of the above-described well, being first duly sworn on oath, says: That I have knowledge of the facts, statements, and matters herein contained and the log of the above-described well as filed and that the same are true and correct. So help me-God.

(Signature) Russell Sullivan
P.O. Box 1082, Great Bend, Kansas
(Address)

Subscribed and Sworn to before me this 3rd day of JUNE, 1969
Shirley Mayer Notary Public.

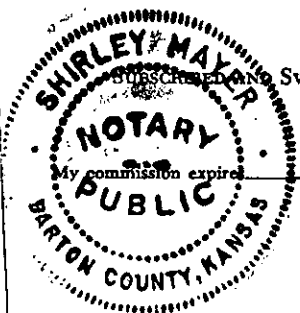

15-047-20016-00-00

RECEIVED
STATE CORPORATION COMMISSION
MAY 26 1969
CONSERVATION DIVISION
Wichita, Kansas

DRILLER'S LOG

COMPANY:	Glen Rupe
CONTRACTOR:	LEBEN DRILLING, INC.
FARM:	CASE #2
LOCATION:	C SW NW SECTION 20-26S-18W
	EDWARDS COUNTY, KANSAS
COMMENCED:	9-25-67
COMPLETED:	10-5-67

0	225	Clay, Sand, Shale Streaks
225	1260	Shale, Redbed
1260	1290	Anhydrite
1290	1960	Shale, Shells
1960	2870	Lime, Shale
2870	2998	Lime
2998	3396	Lime, Shale
3396	4426	Lime
4426	4454	Core
4454	4499	Lime
	<u>4499</u>	<u>RTD - Set 5 1/2" Casing</u>

8 5/8" 28# used surface casing set @ 289' cemented with 250 sacks of Common, 27 cc

I, Leslie Kite, do hereby certify that the above and foregoing is a true and correct copy of the log of the Case #2 Well, located C SW NW of Section 20, Township 26 South, Range 18 West, Edwards County, Kansas, as reflected by the records of Leben Drilling, Inc.

Leslie Kite

Leslie Kite

STATE OF KANSAS)
) SS
COUNTY OF BARTON)

Subscribed and sworn to and before me, a Notary Public, in and for Barton County, Kansas, this 9th day of October, 1967.

Ulanda Nichols

Ulanda Nichols

My Commission Expires:
April 1, 1971