

15-047-20011 - 00-00


STATE OF KANSAS
STATE CORPORATION COMMISSION

Form CP-4

WELL PLUGGING RECORD

Give All Information Completely
Make Required Affidavit
Mail or Deliver Report to:
Conservation Division
State Corporation Commission
P. O. Box 17027
Wichita, Kansas 67217
NORTH

Edwards County, Sec. 20 Twp. 26 Rge. 18 (E) W (W)
Location as "NE/CNWXSW" or footage from lines. C W/2
Lease Owner Glen Rupe
Lease Name Case Well No. # 1
Office Address ~~222 Broadway Bldg. Bldg.~~ 925 O. W. Garvey Bldg. 200 W. Douglas Oil
Character of Well (completed as Oil, Gas or Dry Hole)
Date well completed 9/29/ 1972
Application for plugging filed July 1972
Application for plugging approved July 5, 1972
Plugging commenced July 8 1972
Plugging completed July 13 1972
Reason for abandonment of well or producing formation depleted

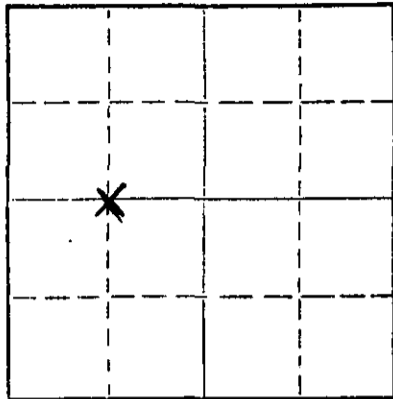

Locate well correctly on above Section Plat

If a producing well is abandoned, date of last production 7/29 1971
Was permission obtained from the Conservation Division or its agents before plugging was commenced? Yes

Name of Conservation Agent who supervised plugging of this well Russell Biberstein
Producing formation Kansas City Depth to top 4430 Bottom 4436' Total Depth of Well 4725 Feet
Show depth and thickness of all water, oil and gas formations.

OIL, GAS OR WATER RECORDS

CASING RECORD

FORMATION	CONTENT	FROM	TO	SIZE	PUT IN	PULLED OUT
				8 5/8"	280	None
				5 1/2"	4725	2201

Describe in detail the manner in which the well was plugged, indicating where the mud fluid was placed and the method or methods used in introducing it into the hole. If cement or other plugs were used, state the character of same and depth placed, from _____ feet to _____ feet for each plug set.

July 8, 1972 Plugged off bottom. Dumped sand to 4300'. Mixed and dumped 5 sx of cement.
July 13, 1972 Plugged off top. Set 10' rock bridge at 225'. Filled 8 5/8" surface casing with 3 1/2 yds. of 3000 pound ready-mix concrete.

RECEIVED
STATE CORPORATION COMMISSION
AUG 11 1972
8-11-72
CONSERVATION DIVISION
Wichita, Kansas

(If additional description is necessary, use BACK of this sheet)
Name of Plugging Contractor RUSS CASING PULLING, INC.
Address P. O. Box 1082 ; Great Bend, Kansas 67530

STATE OF Kansas, COUNTY OF Sedgwick, ss.
G. N. Rupe (Employee or owner) or (owner or operator) of the above-described well, being first duly sworn on oath, says: That I have knowledge of the facts, statements, and matters herein contained and the log of the above-described well as filed and that the same are true and correct. So help me God.

(Signature) G. N. Rupe
925 O. W. Garvey Bldg., 200 W. Douglas
(Address) Wichita, Kansas 67202
1972



Faye W. Leach
Notary Public.

DRILLER'S LOG

COMPANY: Glen Rupe
 CONTRACTOR: LEBEN DRILLING, INC.
 FARM: CASE #1
 LOCATION: C W $\frac{1}{2}$ SECTION 20-26S-18W
 EDWARDS COUNTY, KANSAS
 COMMENCED: 8-23-67
 COMPLETED: 9-5-67

0	225	Sand
225	280	Shale, Clay
280	990	Redbed, Shale
990	1250	Shale
1250	1290	Anhydrite
1290	1700	Shale, Shells
1700	2545	Lime, Shale
2545	3345	Lime
3345	3390	Sand
3390	4710	Lime
4710	4725	Chert
	<u>4725</u>	<u>RTD - Set 5$\frac{1}{2}$" Casing</u>

RECEIVED
 STATE CORPORATION COMMISSION
 JUL 5 1972
 CONSERVATION DIVISION
 Wichita, Kansas

8 5/8" surface casing set @ 280' cemented with 225 sacks Common, 2% cc

I, Leslie Kite, do hereby certify that the above and foregoing is a true and correct copy of the log of the Case #1 Well, located C West Half Section 20, Township 26 South, Range 18 West, Edwards County, Kansas, as reflected by the records of Leben Drilling, Inc.

Leslie Kite
 Leslie Kite

STATE OF KANSAS)
) SS
 COUNTY OF BARTON)

Subscribed and sworn to and before me, a Notary-Public, in and for Barton County, Kansas, this 8th day of September, 1967.

Ulanda Nichols
 Ulanda Nichols

My Commission Expires:
 April 1, 1971