


Give All Information Completely
Make Required Affidavit
Mail or Deliver Report to:
Conservation Division
State Corporation Commission
800 Biting Building
Wichita, Kansas

WELL PLUGGING RECORD

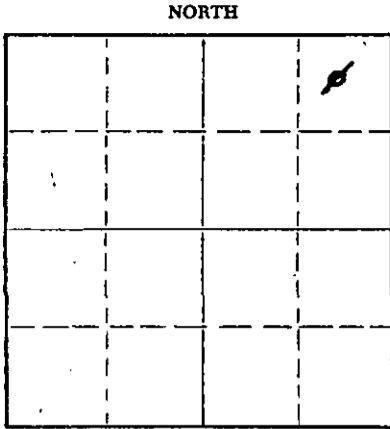

NORTH

Locate well correctly on above
Section Plat

HARPER

County, Sec. 33 Twp. 32S Rge. 2 ~~100~~ 7 (W)

Location as "NE/CNW/SW" or footage from lines NE NE NE

Lease Owner SINCLAIR OIL & GAS COMPANY - Tulsa, Oklahoma

Lease Name George W. SECHLER Well No. 1

Office Address Box 521, Tulsa, Oklahoma

Character of Well (completed as Oil, Gas or Dry Hole) DRY HOLE

Date well completed October 25, 19 54

Application for plugging filed August 16, 19 55

Application for plugging approved August 18, File 113-10 19 55

Plugging commenced August 24, 19 55

Plugging completed August 29, 19 55

Reason for abandonment of well or producing formation Large volume of water and without "deep Disposal" made prospect of producing prohibitive.

If a producing well is abandoned, date of last production August 24, 19 55

Was permission obtained from the Conservation Division or its agents before plugging was commenced? YES

Name of Conservation Agent who supervised plugging of this well Mr. M. A. Rives, Box 8, Pratt, Kansas

Producing formation Simpson Depth to top 4841 Bottom 5004 Total Depth of Well 4841 Feet

Show depth and thickness of all water, oil and gas formations.

OIL, GAS OR WATER RECORDS

CASING RECORD

FORMATION	CONTENT	FROM	TO	SIZE	PUT IN	PULLED OUT
Red Bed & Shells				10-3/4" OD	280'	NONE
Lime & Shale				7" OD	5025'	3465'

Describe in detail the manner in which the well was plugged, indicating where the mud fluid was placed and the method or methods used in introducing it into the hole. If cement or other plugs were used, state the character of same and depth placed, from _____ feet to _____ feet for each plug set.

Orig. TD reached by Rotary 5027'
Top Cement inside 7" (Not Drilled) ~~4986'~~ 4986'
Subsequent "Cement Squeeze" to "Shut Off" Perf. left FBTD @ 4841'

PLUGGING RECORD

	FROM	TO
5-Sacks Cement	4841	4830 (Perf. 4841-43)
Mud	4830	1600'
25 Sacks Jel Mud	1600	280'
10' Rock Bridge	280	270'
25 Sacks Cement (Inside 10-3/4)	270	40'
10' Rock Bridge	40'	30'
10 - Sacks Cement	30'	Bottom Celler
Steel Plate welded over top of 10-3/4" Casing		

(If additional description is necessary, use BACK of this sheet)

Name of Plugging Contractor West Supply Company
Address Chase, Kansas

STATE OF KANSAS COUNTY OF RICE, ss.

I, W. B. RHEES (employee of owner) or (~~conservation agent~~) of the above-described well, being first duly sworn on oath, says: That I have knowledge of the facts, statements, and matters herein contained and the log of the above-described well as filed and that the same are true and correct. So help me God.

(Signature) W. B. RHEES

W. B. RHEES
(Address)

SUBSCRIBED AND SWORN TO before me this 27th day of SEPTEMBER, 19 55

My commission expires 19 June 1959

Notary Public.

PLUGGING
FILE SEC 327-32 R 7W
BOOK PAGE 143 LINE 10

RECEIVED
STATE CORPORATION COMMISSION
SEP 29 1955 9-25-55
CONSERVATION DIVISION
Wichita, Kansas

DRILLERS LOG

Operator- Sinclair Oil and Gas Company,
 Contractor - Adkins Drilling Company, Inc.
 Lease- Sechler No. 1 NE $\frac{1}{4}$ NE $\frac{1}{4}$ NE $\frac{1}{4}$ Sec. 33-32-7W. Harper County, Kansas.

Formation	From	To	Formation	From	To.
Clay & Shells	0	30	Lime & Shale	4172	4358
Red Bed & Shells	30	281	Shale & Lime	4358	4421
			Lime	4421	4505
Set 10 $\frac{3}{4}$ " Spiral weld casing @ 280'			Lime & Shale	4505	4546
cemented with 200 sacks of cement and 200#			Lime	4546	4708
Ca. Cl.			Shale & Lime	4708	4742
Red Bed and shale	280	905	Shale	4742	4820
Sand, Shale & Shells	905	1330			
Shale & Shells	1330	1510	Cored 4820 -	4835	
Shale & Lime	1510	2023	cored 4835	4845	
Lime (Ft. Riley)	2023	2045	cored 4845	4855	
Shale & Lime	2045	2800	Lime	4855	4907
Sandy Lime	2800	2945	Shale & Lime	4907	5014
Shale & Lime	2945	3383	Lime & Shale	5014	5027
Shale	3383	3430			
Shale & Lime	3430	3588	T. D. 5027		
Shale & Sandy Lime	3588	3685			
Sandy Lime	3685	3708	Set 7" O. D. Casing @ 5025'		
Shale	3708	3783	cemented w/ 250 sacks Posmix cement		
Shale & Lime	3783	3912			
Lime	3912	4004			
Shale & Lime	4004	4172			

State of Kansas } ss.
 County of Barton }

JIM ADKINS, of lawful age being first duly sworn deposes and says that the he is the President of the Adkins Drilling Company, Inc. and that the foregoing is a true and correct copy of the Drillers Log in connection with the drilling of the Sechler No. 1 in Sec. 33-32-7W. Harper County, Kansas. to the best of his knowledge & belief.

Subscribed and sworn to before me this 30 day of October 1954.

Jim Adkins

Pauline B. Adkins

 Notary Public

My Comm. Expires

2-29-1956.

PLUGGING
 FILE SEC. 33 T. 32 R. 7W
 BOOK PAGE 43 LINE 10