


Give All Information Completely
Make Required Affidavit
Mail or Deliver Report to:
Conservation Division
State Corporation Commission
211 No. Broadway
Wichita, Kansas

15-007-00246-0000

WELL PLUGGING RECORD

NORTH

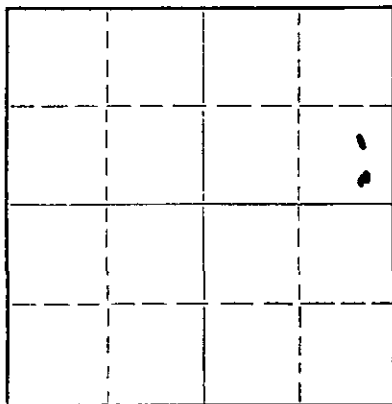

Locate well correctly on above
Section Plat

Barber

County. Sec. 35 Twp. 34S Rge. 12 (X) (W)

Location as "NE/CNW/SW" or footage from lines C SE SE NE

Lease Owner Sinclair Oil & Gas Company

Lease Name Samuel E. Good Well No. 1

Office Address P. O. Box 521, Tulsa, Oklahoma

Character of Well (completed as Oil, Gas or Dry Hole) Dry Hole

Date well completed March 17, 19 56

Application for plugging filed March 21, 19 56

Application for plugging approved March 22, 19 56

Plugging commenced April 7, 19 56

Plugging completed April 11, 19 56

Reason for abandonment of well or producing formation Dry Hole - No producing formation encountered.

If a producing well is abandoned, date of last production Dry Hole 19

Was permission obtained from the Conservation Division or its agents before plugging was commenced? Yes

Name of Conservation Agent who supervised plugging of this well Mr. M. A. Rives, Box 8, Pratt, Kansas

Producing formation None Depth to top Bottom Total Depth of Well 5500' Feet

Show depth and thickness of all water, oil and gas formations.

OIL, GAS OR WATER RECORDS

CASING RECORD

FORMATION	CONTENT	FROM	TO	SIZE	PUT IN	PULLED OUT
NONE - DRY HOLE				10-3/4	260'	None
				5-1/2	4889'	4072'

Describe in detail the manner in which the well was plugged, indicating where the mud fluid was placed and the method or methods used in introducing it into the hole. If cement or other plugs were used, state the character of same and depth placed, from feet to feet for each plug set.

Filled hole with sand to 4770'.
Dumped 5 sacks cement 4770' to 4740'.
Filled hole to surface to free stuck pipe at 1500'.
Bailed mud to 260'.
Set 10' rock bridge at 260' to 250'.
Dumped 25 sacks cement 250' to 175'.
Mudded hole 175' to 30'.
Set 10' rock bridge 30' to 20'.
Dumped 10 sks. cement 20' to 0'. (Surface)
Welded steel plate over surface casing.

(If additional description is necessary, use BACK of this sheet)

Name of Plugging Contractor West Supply Company

Address Chase, Kansas

STATE OF Kansas COUNTY OF Rice
W. B. Rhees (employee of owner) or (owner or operator) of the above-described

well, being first duly sworn on oath, says: That I have knowledge of the facts, statements, and matters herein contained and the log of the above-described well as filed and that the same are true and correct. So help me God.


(Signature) W. B. Rhees

P. O. Box 551, Chase, Kansas

(Address)

SUBSCRIBED AND SWORN to before me this 13th day of April, 19 56

My commission expires 19 June 1959 Notary Public.

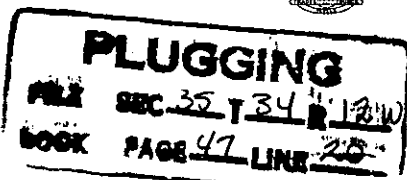

RECEIVED
STATE CORPORATION COMMISSION

4-14-56
CONS
WICHITA


SAMUEL E. GOOD NO. 1

NE/4 of Section 35-34S-12W
Barber County, Kansas
Sinclair Oil and Gas Company

10-3/4" O. D. casing cemented at 268'
5-1/2" O. D. casing cemented at 4889'

Drilling commenced February 7, 1956
Drilling completed March 6, 1956

FROM	TO	FORMATION	REMARKS
0'	100'	Clay & shale	
100	180	Sand & shale	
180	238	Shale	
238	425	Red bed	10-3/4" O. D. casing cemented with
425	770	Shale & gyp	250 sacks common cement at 268'
770	1430	Shale & shells	
1430	1490	Anhydrite	
1490	1705	Sand & shale	
1705	1760	Shale & anhydrite	
1760	1830	Shale & lime	
1830	1865	Lime	
1865	2100	Lime & shale	
2100	2240	Shale & lime	
2240	2484	Lime & shale	
2484	2765	Shale & lime	
2765	2885	Lime & shale	
2885	3140	Shale & lime	
3140	3373	Lime & shale	
3373	3390	Shale & lime	
3390	3513	Lime & shale	
3513	3610	Shale & lime	
3610	3750	Sand & shale	
3750	3835	Shale & lime	
3835	3885	Lime & shale	
3885	4060	Shale & lime	
4060	4116	Lime & shale	
4116	4220	Sand	
4220	4264	Shale & lime	
4264	4362	Lime & shale	
4362	4549	Lime	
4549	4742	Lime & shale	
4742	4792	Shale & lime	Coring 4761'- 4792'
4792	4808	Chert	
4808	4820	Lime & chert	
4820	4861	Lime & shale	
4861	4927	Shale	
4927	4944	Lime & shale	
4944	5192	Shale & lime	
5192	5212	Lime	

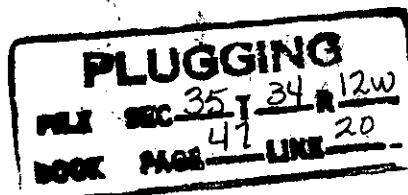

RECEIVED
3-24-56
DIVISION
WICHITA, KANSAS

Sinclair Oil and Gas Company - Samuel E. Good No. 1 - continued:

Page 2.

FROM	TO	FORMATION	REMARKS
5212	5249	Lime & chert	
5249	5270	Shale & lime	
5270	5282	Sand	
5282	5296	Simpson sand	
5296	5321	Sand	
5321	5344	Shale	
5344	5384	Sand & shale	
5384	5442	Shale	
5442	5466	Shale & sand	
5466	5500	Lime	5-1/2" O. D. casing cemented at 4889'
T.D. 5500'			

This is a true copy of the driller's log as shown on the drilling tickets.


BARBOUR DRILLING COMPANY

By Ed. W. Dribel

Subscribed and sworn to before me on this 21st day of March, 1956.

Mary Jane Burt
Notary Public

My commission expires: July 27, 1957

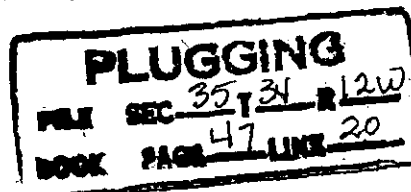

3-24-56