


15-007-20365-0000

STATE OF KANSAS  
STATE CORPORATION COMMISSION  
CONSERVATION DIVISION  
P. O. BOX 17027  
WICHITA, KANSAS 67217

FORM CP-4

WELL PLUGGING RECORD

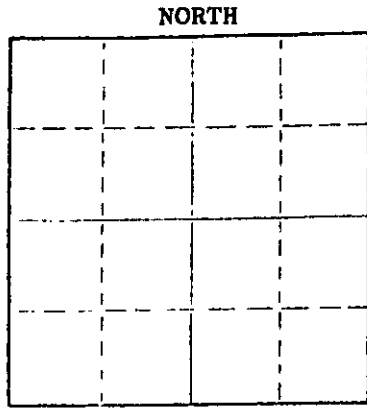

Locate well correctly on above Section Plat

Barber County, Sec. 36 Twp. 34 Rge. (E) 12W(W)  
Location as "NE/CNWKSWK" or footage from lines C NW SW  
Lease Owner D N B DRILLING, INC.  
Lease Name Wetz Well No. 1  
Office Address 701 First Nat'l Bldg., Wichita, Ks. 67202  
Character of Well (completed as Oil, Gas or Dry Hole) Dry Hole  
Date well completed 11-19 19 75  
Application for plugging filed 11-19 19 75  
Application for plugging approved 11-19 19 75  
Plugging commenced 11-19 19 75  
Plugging completed 11-19 19 75  
Reason for abandonment of well or producing formation No commercial quantities of oil or gas encountered.  
If a producing well is abandoned, date of last production 19  
Was permission obtained from the Conservation Division or its agents before plugging was commenced? Yes

Name of Conservation Agent who supervised plugging of this well G. R. Biberstein  
Producing formation \_\_\_\_\_ Depth to top \_\_\_\_\_ Bottom \_\_\_\_\_ Total Depth of Well 5238 feet  
Show depth and thickness of all water, oil and gas formations.

OIL, GAS OR WATER RECORDS

CASING RECORD

FORMATION	CONTENT	FROM	TO	SIZE	PUT IN	PULLED OUT
Surface Hole	Water	Surf	1240	8-5/8"	291	None

Describe in detail the manner in which the well was plugged, indicating where the mud fluid was placed and the method or methods used in introducing it into the hole. If cement or other plugs were used, state the character of same and depth placed, from \_\_\_\_\_ feet to \_\_\_\_\_ feet for each plug set.

Fluid to 250', plug, 35 sx cement;  
Fluid to 40', plug, 15 sx cement;

RECEIVED  
STATE CORPORATION COMMISSION

DEC 4 1975  
12-4-75  
CONSERVATION DIVISION  
WICHITA, KANSAS

Name of Plugging Contractor D N B DRILLING, INC.  
Address 701 First National Building  
Wichita, Kansas 67202

STATE OF KANSAS COUNTY OF \_\_\_\_\_ ss.  
JAMES L. DONELSON (employee of owner) or (owner or operator) of the above-described well, being first duly sworn on oath, says: That I have knowledge of the facts, statements, and matters herein contained and the log of the above-described well as filed and that the same are true and correct. So help me God.

(Signature) James L. Donelson  
701 First Nat'l Bldg., Wichita, Kansas  
(Address)

SUBSCRIBED AND SWORN TO before me this 2nd day of December 1975

My commission expires August 25, 1976

Ella Priess  
Ella Priess Notary Public.

Ella Priess  
STATE NOTARY PUBLIC  
Sedgwick County, Kansas  
My Com. Expires Aug. 25, 1976

DRILLERS' LOG

D N B DRILLING, INC.  
 No. 1 Wetz  
 C NW SW, Sec. 36-34S-12W  
 Barber County, Kansas

Elev: 1438 K.B.

Commenced: 11-7-75  
 Completed: 11-19-75

Surface Casing: 291' of 8-5/8" used casing cemented w/225 sx common cement, 2% Gel, 3% cc. 11-8-75

<u>FORMATION</u>	<u>DEPTH</u>
Surface Hole	0 - 285
Shale & Sand	285- 840
Rat Hole	840- 1240
12-1/4 Ream Hole	285 - 298
Shale & Sand	1240- 1800
Shale	1800- 2070
Shale & Lime	2070-2890
Lime & Shale	2890-3160
Shale	3160-3450
Shale & Sand	3450-3630
Sand, Shale & Lime	3630-3845
Shale & Lime	3845-4252
Shale	4252-4362
Shale & Lime	4362-4465
Lime	4465-4680
Shale & Lime	4680-4780
Lime	4780-4932
Lime & Chert	4932-5002
Lime	5002-5238 RTD

RECEIVED  
 STATE CORPORATION COMMISSION

DEC 4 1975  
 12-4-75  
 CONSERVATION DIVISION  
 Wichita, Kansas

I do hereby certify that the foregoing statements are true and correct to the best of my knowledge and belief.

D N B DRILLING, INC.

*James L. Donelson*  
 JAMES L. DONELSON

STATE OF KANSAS: ss:

Subscribed and sworn to before me this 2nd day of December 1975.

*Ella Priess*

Ella Priess, Notary Public

*Ella Priess*  
 STATE NOTARY PUBLIC  
 Sedgwick County, Kansas  
 My Com. Expires Aug. 25, 1976