


STATE OF KANSAS
STATE CORPORATION COMMISSION

Form CP-4

Give All Information Completely
Make Required Affidavit
Mail or Deliver Report to:
Conservation Division
State Corporation Commission
212 No. Market
Wichita, Kansas 67202

WELL PLUGGING RECORD

NORTH

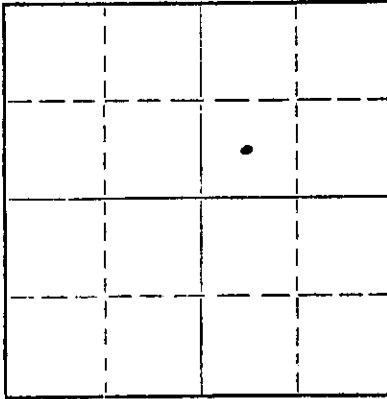

Locate well correctly on above
Section Plat

Barber County, Sec. 13 Twp. 34S Rge. 12 (E) W (W)

Location as "NE/CNW/SW" or footage from lines SW NE
Lease Owner Oleum Incorporated
Lease Name Humphrey Well No. 1-13
Office Address Drawer 2232 - Longview, Texas 75601
Character of Well (completed as Oil, Gas or Dry Hole) Oil
Date well completed September 30 19 69
Application for plugging filed November 7 19 74
Application for plugging approved December 5 19 74
Plugging commenced October 29 19 74
Plugging completed October 31 19 74
Reason for abandonment of well or producing formation Nonproductive

If a producing well is abandoned, date of last production July 19 74
Was permission obtained from the Conservation Division or its agents before plugging was commenced? _____

Name of Conservation Agent who supervised plugging of this well _____
Producing formation Mississippi Chat Depth to top 4674' Bottom 4677' Total Depth of Well 4,820 Feet
Show depth and thickness of all water, oil and gas formations.

OIL, GAS OR WATER RECORDS

CASING RECORD

FORMATION	CONTENT	FROM	TO	SIZE	PUT IN	PULLED OUT
Mississippi Chat	Oil/Gas	4674	4677	8-5/8"	422	-0-
				5-1/2"	4813	2455

Describe in detail the manner in which the well was plugged, indicating where the mud fluid was placed and the method or methods used in introducing it into the hole. If cement or other plugs were used, state the character of same and depth placed, from _____ feet to _____ feet for each plug set.

Mixed 50 sacks of mud and pumped into well.

Mixed and pumped 25 sacks of cement from 4,561' to 4,674'.

Shot off 5-1/2" casing @ 2,455' and pulled out of well.

Spotted 100 sacks cement from 372' to 472'.

Ran 15 saks from 5' to 35'.

RECEIVED
STATE CORPORATION COMMISSION
DEC 11 1974
12-11-74
CONSERVATION DIVISION
Wichita, Kansas

(If additional description is necessary, use BACK of this sheet)

Name of Plugging Contractor Daco Lease and Well Service
Address 1700 S. Main - Borger, Texas 79007

STATE OF TEXAS, COUNTY OF GREGG, SS.
Charles L. Novy (employee of owner) ~~owner or operator~~ of the above-described

well, being first duly sworn on oath, says: That I have knowledge of the facts, statements and matters herein contained and the log of the above-described well as filed and that the same are true and correct. So help me God.

(Signature)

Charles L. Novy
Drawer 2232 - Longview, Texas
(Address)

SUBSCRIBED AND SWORN TO before me this 9th day of December, 19 74

My commission expires June 1, 1974

Vernell Minnich

Vernell Minnich
Notary Public.

15-007-20116-0000

RECEIVED
STATE CORPORATION COMMISSION
DEC 5 1974
12-5-74
CONSERVATION DIVISION
Wichita, Kansas

DEC 5 1974
12-5-74
CONSERVATION DIVISION
Wichita, Kansas

DEPTH		FORMATION	REMARKS
From	To		
0	1000	Red beds	Ran 13 joints 8-5/8" casing, set @ 412'. Cemented with 300 sacks regular plus 2% calcium chloride.
1000	1275	Red beds and shale	
1275	4155	Lime and shale	
4155	4820	Lime	
4820	TD		Ran 151 joints 5-1/2" casing to 4,813'. Cemented with 125 sacks.

CHARLES L. NOVY

Vernell Minnich
Vernell Minnich, Notary Public

My Commission Expires June 1, 1975.