


STATE OF KANSAS  
STATE CORPORATION COMMISSION

WELL PLUGGING RECORD

Give All Information Completely  
Make Required Affidavit  
Mail or Deliver Report to:  
Conservation Division  
State Corporation Commission  
212 North Market, Insurance Bldg.  
Wichita, Kansas

14

NORTH

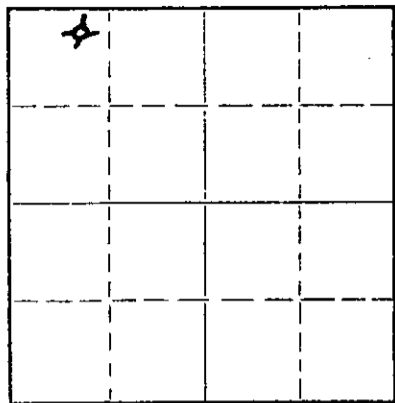

Locate well correctly on above  
Section Plat

Barber County. Sec. 17 Twp. 34S Rge. (E) 15 (W)  
Location as "NE/CNW/SE/SW" or footage from lines NE-NW-NW  
Lease Owner Champlin Oil & Refining Co.  
Lease Name Davis Ranch "L" Well No. 1  
Office Address Box 308, Ellinwood, Kansas  
Character of Well (completed as Oil, Gas or Dry Hole) Dry Hole  
Date well completed October 11, 19 61  
Application for plugging filed October 12, 19 61  
Application for plugging approved October 11, (Verbal) 19 61  
Plugging commenced October 12, 19 61  
Plugging completed October 12, 19 61  
Reason for abandonment of well or producing formation

If a producing well is abandoned, date of last production 19  
Was permission obtained from the Conservation Division or its agents before plugging was com-  
menced? Yes

Name of Conservation Agent who supervised plugging of this well W. L. LacKamp  
Producing formation Depth to top Bottom Total Depth of Well Feet  
Show depth and thickness of all water, oil and gas formations.

OIL, GAS OR WATER RECORDS

CASING RECORD

FORMATION	CONTENT	FROM	TO	SIZE	PUT IN	PULLED OUT
				13 3/8"OD	297'	None

Describe in detail the manner in which the well was plugged, indicating where the mud fluid was placed and the method or methods used in introducing it into the hole. If cement or other plugs were used, state the character of same and depth placed, from feet to feet for each plug set.

Filled with heavy rotary mud from 4853' TD to 295' and set plug with 1/2 sack of hulls on top then pumped in 25 sacks of cement. Filled hole with heavy mud to 40' and set plug with 1/2 sack of hulls on top then pumped in 20 sacks of cement filling hole to bottom of cellar.

RECEIVED  
STATE CORPORATION COMMISSION  
OCT 13 1961  
10-13-61  
CONSERVATION DIVISION  
Wichita, Kansas

(If additional description is necessary, use BACK of this sheet)

Name of Plugging Contractor  
Address

STATE OF KANSAS, COUNTY OF BARTON, ss.

J. W. Meyers (employee of owner) or (owner or operator) of the above-described well, being first duly sworn on oath, says: That I have knowledge of the facts, statements, and matters herein contained and the log of the above-described well as filed and that the same are true and correct. So help me God.

(Signature) [Signature]  
Box 308, Ellinwood, Kansas (Address)

SUBSCRIBED AND SWORN to before me this 12th day of October 19 61

My commission expires 5-22-62 Notary Public.

Champlin Oil & Refining Co.

Davis Ranch L #1 14w

NE-NW-NW Sec. 17-34S-15W

Barber County, Kansas

Formation Log

0 - 140' Red Bed  
140' - 299' Sand & Shale  
299' - 1470' Shale & Shells  
1470' - 1900' Shale & Lime  
1900' - 2435' Lime & Shale  
2435' - 3978' Shale & Lime  
3978' - 4340' Lime & Shale  
4340' - 4767' Lime  
4767' - 4790' Shale & Lime  
4790' - 4815' Lime & Chert  
4815' - 4853' Lime & Chert  
4853' - Total Depth

RECEIVED  
STATE CORPORATION COMMISSION

OCT 13 1961  
10-13-61  
CONSERVATION DIVISION  
Wichita, Kansas