


STATE OF KANSAS  
STATE CORPORATION COMMISSION

WELL PLUGGING RECORD

Give All Information Completely  
Make Required Affidavit  
Mail or Deliver Report to  
Conservation Division  
State Corporation Comm.  
245 North Water  
Wichita, KS 67202

Barber County, Sec. 13 Twp. 34S Rge. 14 E/W  
Location as "NE/CNW $\frac{1}{4}$ SW $\frac{1}{4}$ " or footage from lines SE/4  
660' S. of N line, 550' W of E line  
Lease Owner Professional Petroleum, Inc.  
Lease Name Albert Bouziden Well No. 13-1  
Office Address 2601 NW Expressway, St 512-OKC, OK  
Character of Well (Completed as Oil, Gas or Dry Hole) Dry Hole

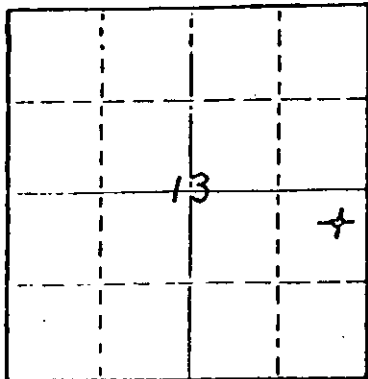

Locate well correctly on above  
Section Plot

Date Well completed 1-3-82 1982  
Application for plugging filed 1-3 1982  
Application for plugging approved 1-3 1982  
Plugging commenced 1-4 1982  
Plugging completed 1-4 1982  
Reason for abandonment of well or producing formation Dry Hole

If a producing well is abandoned, date of last production 1982

Was permission obtained from the Conservation Division or its agents before plugging was commenced? Yes

Name of Conservation Agent who supervised plugging of this well Morris Leslie  
Producing formation Mississippi Depth to top 4748' Bottom 4944' Total Depth of Well 4970'  
Show depth and thickness of all water, oil and gas formations.

OIL, GAS OR WATER RECORDS

CASING RECORD

FORMATION	CONTENT	FROM	TO	SIZE	PUT IN	PULLED OUT
No test						

Describe in detail the manner in which the well was plugged, indicating where the mud fluid was placed and the method or methods used in introducing it into the hold. If cement or other plugs were used, state the character of same and depth placed, from \_\_\_\_\_ feet to \_\_\_\_\_ feet for each plug set. Circulate hole with 9.2 per gallon mud, pull drill pipe to 1375', pump 60 sacks class H cement with 2% gel, 3% calcium chloride (cement plug 1375' to 1151'). Pull drill pipe to 393' and pump 60 sacks of class H cement 2% gel, 3% calcium chloride. Cement plug 393' to 239'. Pull drill pipe to 40', pump 15 sacks of cement, 2% gel, 3% calcium chloride. Circulate cement to surface. Cut surface pipe 3 feet below ground level and weld plate over the top. Circulate thru joint of drill pipe 5 sacks of cement in mouse hole 2% gel, 3% calcium chloride. Circulate thru joint of drill pipe ten sacks of cement in rathole, 2% gel, 3% calcium chloride.

(If additional description is necessary, use BACK of this sheet)

Name of Plugging Contractor Allied Cementing

RECEIVED  
1-15-82  
JAN 15 1982

STATE OF Oklahoma COUNTY OF Oklahoma

I.G. Purser-President of Prof. Petro. Inc. (employee of owner) or (owner or operator) of the above-described well, being first duly sworn on oath, says: That I have knowledge of the facts, statements, and matters herein contained and the log of the above-described well as filed and that the same are true and correct. So help me God.

(Signature)

2601 NW Expressway-St 512 W. OKC, OK

(Address) 73112

SUBSCRIBED AND SWORN TO before me this 13<sup>th</sup> day of JANUARY, 1982

Notary Public.

My commission expires My Commission Expires Oct. 19, 1985