


STATE OF KANSAS
STATE CORPORATION COMMISSION

Form CP-4

Give All Information Completely
Make Required Affidavit
Mail or Deliver Report to:
Conservation Division
State Corporation Commission
212 No. Market
Wichita, Kansas

WELL PLUGGING RECORD

NORTH

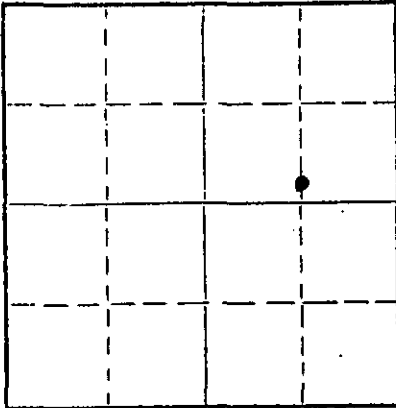

Locate well correctly on above
Section Plat

Barber County, Sec. 13 Twp. 34S Rge. - (E) 14 (W)
Location as "NE/CNW/SW" or footage from lines 100' N of C of E/2 of Sec. 13
Lease Owner Shenandoah Oil Corporation
Lease Name Birdie B. Clarke "A" Well No. 1
Office Address 1018 Commerce Bldg., Fort Worth, Texas
Character of Well (completed as Oil, Gas or Dry Hole) Dryhole
Date well completed 7-7 19 67
Application for plugging filed November 29 19 67
Application for plugging approved November 30 19 67
Plugging commenced January 10 19 68
Plugging completed January 13 19 68
Reason for abandonment of well or producing formation Non-Commercial

If a producing well is abandoned, date of last production - 19 -
Was permission obtained from the Conservation Division or its agents before plugging was commenced? Yes

Name of Conservation Agent who supervised plugging of this well Mr. Archie Elving
Producing formation Mississippi Depth to top 4754 Bottom 4774 Total Depth of Well 4855 Feet
Show depth and thickness of all water, oil and gas formations.

OIL, GAS OR WATER RECORDS

CASING RECORD

FORMATION	CONTENT	FROM	TO	SIZE	PUT IN	PULLED OUT
Mississippi	Oil, gas & wtr.	4708	4760	8-5/8	250	None
				4-1/2	4855	3336'

Describe in detail the manner in which the well was plugged, indicating where the mud fluid was placed and the method or methods used in introducing it into the hole. If cement or other plugs were used, state the character of same and depth placed, from - feet to - feet for each plug set.

Set 50 sack cement plug from 4650' to 4779'

Ripped 4 1/2" casing at 3336'. Pulled 103 jts 4 1/2" casing.
Bailed hole down to 300'.

Set wood bridge at 300', rock bridge from 300' - 290'.

Set 25 sack cement plug from 290' to 215'.

Filled hole w/ mud from 215' to 40'.

Set rock bridge from 40' to 30'.

Set 10 sack cement plug from 30' to surface.

RECEIVED
STATE CORPORATION COMMISSION
1-22-68
JAN 22 1968
CONSERVATION DIVISION
Wichita, Kansas

(If additional description is necessary, use BACK of this sheet)

Name of Plugging Contractor Clarke Corporation
Address Medicine Lodge, Kansas

STATE OF Texas, COUNTY OF Tarrant, ss.
Harold E. Burke (employee of owner) or (owner or operator) of the above-described

well, being first duly sworn on oath, says: That I have knowledge of the facts, statements, and matters herein contained and the log of the above-described well as filed and that the same are true and correct. So help me God.

(Signature) Harold E. Burke

1018 Commerce Bldg., Fort Worth, Texas
(Address)

SUBSCRIBED AND SWORN to before me this 18th day of January, 1968

My commission expires June 1, 1969

Notary Public.