

140

WELL PLUGGING RECORD

Give All Information Completely
Make Required Affidavit
Mail or Deliver Report to:
Conservation Division
State Corporation Commission
211 No. Broadway
Wichita, Kansas

Barber County, Sec. 8 Twp. 34S Rge. (X) 14 (W)

Location as "NE/CNW%SW%" or footage from lines Ctr. SE-NW

Lease Owner Champlin Oil & Refining Co.

Lease Name Davis Ranch "P" Well No. 1

Office Address Box 308, Ellinwood, Kansas

Character of Well (completed as Oil, Gas or Dry Hole) Dry Hole

Date well completed December 6 19 62

Application for plugging filed December 6 19 62

Application for plugging approved December 6 (Verbal) 19 62


Plugging commenced December 6 19 62

Plugging completed December 6 19 62

Reason for abandonment of well or producing formation

If a producing well is abandoned, date of last production 19

Was permission obtained from the Conservation Division or its agents before plugging was commenced? Yes

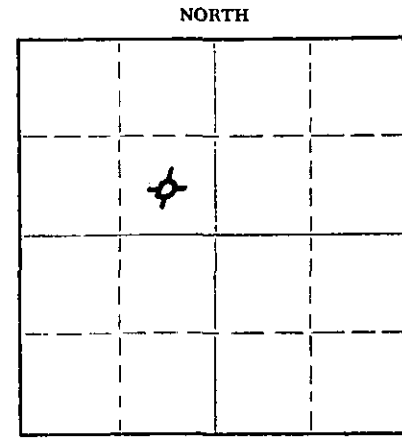

Locate well correctly on above Section Plat

Name of Conservation Agent who supervised plugging of this well

Producing formation Depth to top Bottom Total Depth of Well 4826 Feet

Show depth and thickness of all water, oil and gas formations.

OIL, GAS OR WATER RECORDS

CASING RECORD

FORMATION	CONTENT	FROM	TO	SIZE	PUT IN	PULLED OUT
				13 3/8"OD	200'	None

Describe in detail the manner in which the well was plugged, indicating where the mud fluid was placed and the method or methods used in introducing it into the hole. If cement or other plugs were used, state the character of same and depth placed, from feet to feet for each plug set.

Filled hole with heavy rotary mud from 4826' TD to 190'
Then pushed plug and 1/2 sack of hulls to 190' and pumped
30 sacks of cement down thru drill pipe. Filled with heavy
mud from top of cement to 40' and pushed plug and 1/2 sack
of hulls to 40' and pumped in 13 sacks of cement filling
hole to bottom of cellar.

RECEIVED
STATE CORPORATION COMMISSION

DEC 11 1962

12-11-62
CONSERVATION DIVISION
Wichita, Kansas

(If additional description is necessary, use BACK of this sheet)

Name of Plugging Contractor H-30 Drilling, Inc. (Rotary)

Address 200 N. Main, Wichita, Kansas

STATE OF Kansas, COUNTY OF Barton, ss.

J. W. Meyers

(employee of owner) or (Notary Public)

well, being first duly sworn on oath, says: That I have knowledge of the facts, statements, and matters herein contained and the log of the above-described well as filed and that the same are true and correct. So help me God.

(Signature) *J. W. Meyers*

Box 308, Ellinwood, Kansas

(Address)

SUBSCRIBED AND SWORN TO before me this 10th day of December 19 62

M. Kenneth Stum

My commission expires 5-22-66

Notary Public.



Champlin Oil & Refining Co.
 Davis Ranch "P" #1
 Ctr. SE-NW Sec. 8-34S-14W
 Barber County, Kansas

FILED
 STATE CORPORATION

DEC 7 1962

12-7-62

CONSERVATION
 Wichita, Kansas

Formation Log

0' - 40'	Surface sand & shale (Fill)
40' - 500'	Sand & Shale
500' - 1760'	Shale & shells
1760' - 2195'	Lime & shale
2195' - 2290'	Shale & lime
2290' - 2355'	Lime & shale
2355' - 2505'	Lime
2505' - 2545'	Lime & shale
2545' - 2615'	Lime
2615' - 4175'	Shale & lime
4175' - 4285'	Lime
4285' - 4320'	Lime & shale
4320' - 4750'	Lime
4775' - 4790'	Lime & shale
4790' - 4826'	Lime
4826	Total Depth