


Give All Information Completely
Make Required Affidavit
Mail or Deliver Report to:
Conservation Division
State Corporation Commission
211 No. Broadway
Wichita, Kansas

WELL PLUGGING RECORD

Barber County, Sec. 8 Twp. 34S Rge. 14 (E) (W)
Location as "NE/CNWxSWx" or footage from lines C SE
Lease Owner F.C.D., Oil Corporation
Lease Name Whittlesey Well No. 1-8
Office Address 2200 NW 50th, Suite 200 OKC, OK 73112
Character of Well (completed as Oil, Gas or Dry Hole) Dry Hole
Date well completed 8-31 19 82
Application for plugging filed April 7 19 82
Application for plugging approved April 12 19 82
Plugging commenced July 20, 19 82
Plugging completed August 31, 19 82
Reason for abandonment of well or producing formation Dry

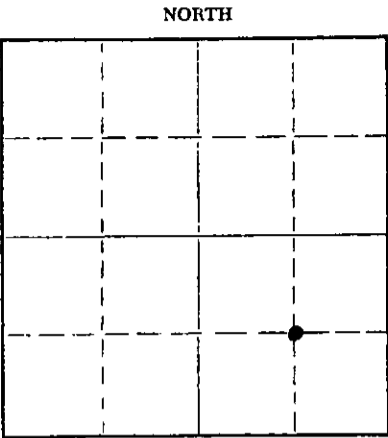

Locate well correctly on above Section Plat

If a producing well is abandoned, date of last production - 19
Was permission obtained from the Conservation Division or its agents before plugging was commenced? Yes

Name of Conservation Agent who supervised plugging of this well Mr. Leslie
Producing formation Mississippi Depth to top 4770 Bottom 4790 Total Depth of Well 4964 Feet
Show depth and thickness of all water, oil and gas formations.

OIL, GAS OR WATER RECORDS

CASING RECORD

FORMATION	CONTENT	FROM	TO	SIZE	PUT IN	PULLED OUT
Oswego	Oil & Gas	4572	4578	8-5/8"	907'	None
Mississippi	Oil & Gas	4770	4790	4-1/2"	4915'	2010.91'

Describe in detail the manner in which the well was plugged, indicating where the mud fluid was placed and the method or methods used in introducing it into the hole. If cement or other plugs were used, state the character of same and depth placed, from _____ feet to _____ feet for each plug set.

A 35 sack cement plug was pumped to 4300 feet with mud laden fluid.
Pipe was shot free at 1998 feet and pulled.
Pumped 150 sack cement plug to 450'.
Capped surface pipe with 25 sack cement plug. Cut off surface pipe and welded on steel plate.

RECEIVED
STATE CORPORATION COMMISSION
SEP 16 1982
9-16-82
CONSERVATION DIVISION
Wichita, Kansas

(If additional description is necessary, use BACK of this sheet)
Name of Plugging Contractor Reeves & Wilson, Inc.
Address P. O. Box 94204, Oklahoma City, Oklahoma 73113

STATE OF Oklahoma, COUNTY OF Oklahoma, ss.
Jeff Hume (employee of owner) or (owner or operator) of the above-described well, being first duly sworn on oath, says: That I have knowledge of the facts, statements, and matters herein contained and the log of the above-described well as filed and that the same are true and correct. So help me God.

(Signature) [Signature]
2200 NW 50th, Suite 200 OKC, OK 73112 (Address)

SUBSCRIBED AND SWORN to before me this 15th day of September, 1982

My commission expires 3/3/84 [Signature] Notary Public.

15-007-21045-0000
WELL LOG

COMPANY FCD Oil Corporation

SEC. 8 T. 34S R. 14W

FARM Whittlesey

NO. 1-8

LOC. G SE


TOTAL DEPTH 4964'

COUNTY Barber, Kansas

COMM. 12-20-80

COMP. 12-31-80

CONTRACTOR DaMac Drilling Inc.

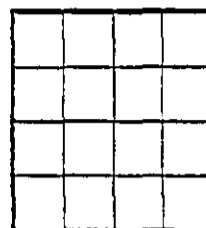

CASING Conductor: 20" set @ 50'
Surface: 8 5/8 set @ 550'

ELEVATION

PRODUCTION 4 1/2 set @ 4915

FIGURES INDICATE BOTTOM OF FORMATIONS

Surface Sand	0	938
Shale	938	2775
Lime, Shale	2775	4994
Lime	4994	4964 RTD

RECEIVED
STATE CORPORATION COMMISSION

APR - 9 10 00
4-9-82
CONSERVATION DIVISION
Wichita, Kansas

RECEIVED
STATE CORPORATION COMMISSION

APR - 9 10 00
CONSERVATION DIVISION
Wichita, Kansas

State of Kansas }
County of Barton } SS

I, Martha J. McKown of DaMac Drilling Inc.

upon oath state the above and foregoing is a true and correct copy of the log of the Whittlesey 1-8 well.

Subscribed and sworn to before me this 31st day of December 1980

My Commission Expires: _____

Martha J. McKown
Vada I. Sullivan
VADA I. SULLIVAN
Barton County, Kansas
NOTARY PUBLIC