


STATE OF KANSAS
STATE CORPORATION COMMISSION

Give All Information Completely
Make Required Affidavit
Mail or Deliver Report to:
Conservation Division
State Corporation Commission
211 No. Broadway
Wichita, Kansas

WELL PLUGGING RECORD

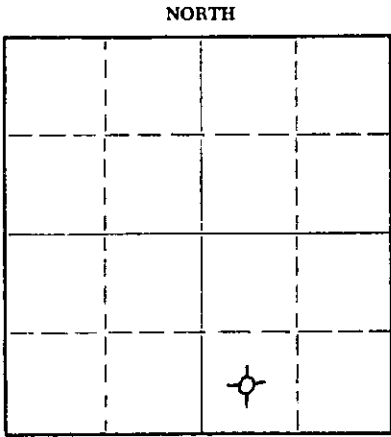

Locate well correctly on above
Section Plat

Barber County. Sec. 7 Twp. 34S Rge. 14W (E) (W)
Location as "NE/CNW/SW" or footage from lines SW SE
Lease Owner Bachus Oil Company
Lease Name Davis Ranch Well No. C-1
Office Address 721 E. Central, Wichita 2, Kansas
Character of Well (completed as Oil, Gas or Dry Hole) Dry Hole
Date well completed 7/4/62 19
Application for plugging filed 7/4/62 19
Application for plugging approved 7/4/62 19
Plugging commenced 7/4/62 19
Plugging completed 7/4/62 at 4:00 PM 19
Reason for abandonment of well or producing formation Dry

If a producing well is abandoned, date of last production --- 19
Was permission obtained from the Conservation Division or its agents before plugging was commenced? Yes

Name of Conservation Agent who supervised plugging of this well Howard Hess, Winfield, Kansas
Producing formation Mississippian Depth to top 4770 Bottom 4840 Total Depth of Well 4840 Feet
Show depth and thickness of all water, oil and gas formations.

OIL, GAS OR WATER RECORDS

CASING RECORD

FORMATION	CONTENT	FROM	TO	SIZE	PUT IN	PULLED OUT
				13 3/8	238	-0-

Describe in detail the manner in which the well was plugged, indicating where the mud fluid was placed and the method or methods used in introducing it into the hole. If cement or other plugs were used, state the character of same and depth placed, from _____ feet to _____ feet for each plug set.
Filled with mud from 4840 to 255, set plug at 255 with 1/2 sack hulls and 15 sacks cement through drill pipe. Filled with mud from 255 to 40, set plug at 40 with 1/2 sack hulls, 10 sacks cement. Put 2 sacks cement in rat hole.

RECEIVED
STATE CORPORATION COMMISSION
JUL 11 1962
7-11-62
CONSERVATION DIVISION
Wichita, Kansas

(If additional description is necessary, use BACK of this sheet)
Name of Plugging Contractor Bachus Oil Company
Address 721 E. Central

STATE OF KANSAS, COUNTY OF Sedgwick, ss.
Nelson R. Thomas (employee of owner) or (owner or operator) of the above-described well, being first duly sworn on oath, says: That I have knowledge of the facts, statements, and matters herein contained and the log of the above-described well as filed and that the same are true and correct. So help me God.

(Signature) Nelson R. Thomas
721 E. Central, Wichita 2, Kansas
(Address)

SUBSCRIBED AND SWORN to before me this 9th day of July, 19 62

My commission expires Oct. 14, 1964
Lovene C. Ehrsam Notary Public.

DAVIS RANCH 1-C

Casing Record:	Company: Bachus Oil Company	Location: SW SE
13 3/8 at 238'	Contractor: Bachus Oil Company	Sec. 7-34S-14W
w/275 sacks	Commenced: June 19, 1962	Barber County,
cement 2% CaCl.	Completed: July 4, 1962	Kansas
		Elevation: 1662 KB
		Production: D & A.

	<u>From</u>	<u>To</u>	<u>Remarks</u>
Alluvium	0	40	Formation Tops:
Shale & Shells	40	240	Elevation 1662 KB
Red Bed & Shells	240	965	Heebner 3960 (-2298)
Shells & Shale	965	1139	Douglas 3996 (-2334)
Shale	1139	1635	Lansing 4170 (-2508)
Lime & Shale	1635	1770	Marmaton 4672 (-3010)
Lime	1770	1945	Cherokee 4760 (-3098)
Lime & Shale	1945	2050	Mississippian 4770 (-3108)
Lime	2050	2140	Total Depth 4840 (-3178)
Shale & Lime	2140	2220	
Lime	2220	2290	
Lime & Shale	2290	2440	
Lime	2440	2480	DST #1 4773-4792
Lime & Shale	2480	3475	Open 1 1/2 hr.
Lime & Chalk	3475	3555	Rec. 30' VSO & GCM
Chalk	3555	3715	FP 20-20
Lime & Shale	3715	3725	BHP 130/30-130/30
Shale	3725	3918	HH 2560 2560
Shale & Sand	3918	4051	T. 112 degrees
Shale, Sand & Lime	4051	4175	
Lime	4175	4210	
Chalk & Lime	4210	4295	DST #2 4792 -4840
Chalk Lime & Shale	4295	4350	Open 1 hr.
Lime	4350	4480	Rec. 60' VSO & GCM
Lime & Shale	4480	4510	FP 40-50
Lime	4510	4555	BHP 140/30-90/30
Lime & Shale	4555	4658	HH 2620-2620
Lime	4658	4772	T. 113 degrees
Miss. Chert & Del.	4772	4840	
Totl. Depth	4840		

I hereby certify that this is a true and correct copy of the above log to the best of my knowledge.

Nelson R. Thomas
Nelson R. Thomas

Subscribed and sworn to before me this 9th day of July, 1962

Lovene C. Ehrsam
Lovene C. Ehrsam, Notary Public

My commission expires October 14th, 1964.

RECEIVED
STATE CORPORATION COMMISSION
JUL 11 1962
7-11-62
CONSERVATION DIVISION
Wichita, Kansas