


WELL PLUGGING RECORD

Give All Information Completely
Make Required Affidavit
Mail or Deliver Report to:
Conservation Division
State Corporation Commission
211 No. Broadway
Wichita, Kansas

NORTH

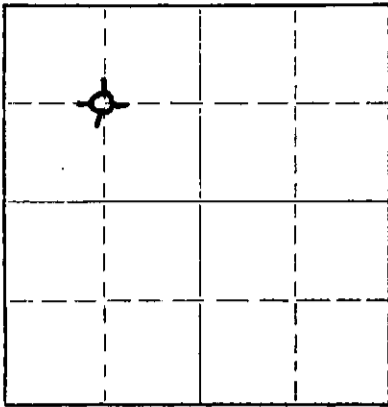

Locate well correctly on above
Section Plat

Barber County. Sec. 6 Twp. 34 Rge. 14 (X) W (W)
Location as "NE/CNW*SW*" or footage from lines C NW/4
Lease Owner Champlin Petroleum Company
Lease Name Davis Ranch "E" Well No. 1
Office Address Box 308, Ellinwood, Kansas 67526
Character of Well (completed as Oil, Gas or Dry Hole) Dry
Date well completed 8-6 1959
Application for plugging filed 11-5 1965
Application for plugging approved 11-8 1965
Plugging commenced 11-11 1965
Plugging completed 11-15 1965
Reason for abandonment of well or producing formation Depleted

If a producing well is abandoned, date of last production _____ 19____
Was permission obtained from the Conservation Division or its agents before plugging was commenced? Yes

Name of Conservation Agent who supervised plugging of this well Archie Elving
Producing formation _____ Depth to top _____ Bottom _____ Total Depth of Well 4960 Feet
Show depth and thickness of all water, oil and gas formations.

OIL, GAS OR WATER RECORDS

CASING RECORD

FORMATION	CONTENT	FROM	TO	SIZE	PUT IN	PULLED OUT
				13-5/8"	458'	None
				4 1/2"	4960'	3976'

Describe in detail the manner in which the well was plugged, indicating where the mud fluid was placed and the method or methods used in introducing it into the hole. If cement or other plugs were used, state the character of same and depth placed, from _____ feet to _____ feet for each plug set.

Checked hole to 4960', sanded hole to 4860' and dumped 3 sacks of cement @ 4860' with dump bailer. Pulled 4 1/2" casing, set rock bridge from 300' to 290' and dumped 40 sacks of cement @ 290'. Mudded hole to 40', set rock bridge to 25' and ran 20 sacks of cement to base of cellar.

NOV 23 1965
11-23-65
CONSERVATION DIVISION
Wichita, Kansas

(If additional description is necessary, use BACK of this sheet)

Name of Plugging Contractor Knight Casing Pulling Company
Address Chase, Kansas

STATE OF KANSAS, COUNTY OF BARTON
J. W. Meyers (employee of owner) or (owner) of the above-described

well, being first duly sworn on oath, says: That I have knowledge of the facts, statements, and matters herein contained and the log of the above-described well as filed and that the same are true and correct. So help me God.

(Signature) [Signature]
Box 308, J. W. Meyers, Kansas 67526
(Address)

SUBSCRIBED AND SWORN to before me this 22nd day of November, 1965

My commission expires 5-22-66
N. Kenneth Stivers Notary Public.