

Give All Information Completely
Make Required Affidavit
Mail or Deliver Report to:
Conservation Division
State Corporation Commission
212 No. Market
Wichita, Kansas

WELL PLUGGING RECORD

Harper County, Sec. 13 Twp. 32S Rge. 6W (W)

Location as "NE/CNWXSWK" or footage from lines. NE SE NE

Lease Owner D. R. Lauck Oil Company, Inc.

Lease Name Pelzi Well No. 1

Office Address 301 S. Broadway, Wichita, Kansas

Character of Well (completed as Oil, Gas or Dry Hole) Dry Hole

Date well completed May 31, 19.67

Application for plugging filed May 31, 19.67

Application for plugging approved May 31, 19.67


Plugging commenced May 31, 19.67

Plugging completed May 31, 19.67

Reason for abandonment of well or producing formation Dry Hole

If a producing well is abandoned, date of last production 19.

Was permission obtained from the Conservation Division or its agents before plugging was commenced? Yes

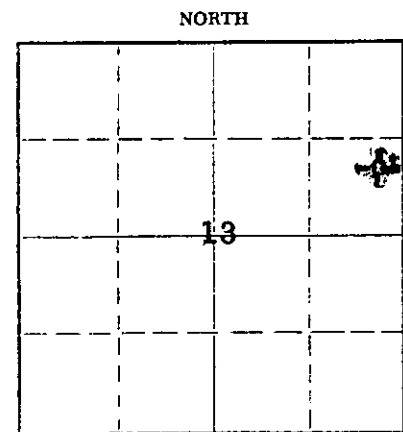

Locate well correctly on above Section Plat

Name of Conservation Agent who supervised plugging of this well Archie Elving

Producing formation _____ Depth to top _____ Bottom _____ Total Depth of Well 4726 Feet

Show depth and thickness of all water, oil and gas formations.

OIL, GAS OR WATER RECORDS

CASING RECORD

FORMATION	CONTENT	FROM	TO	SIZE	PUT IN	PULLED OUT
		0'	223'	8-5/8"	223'	None

RECEIVED
STATE CORPORATION COMMISSION
JUN 9 1967
CONSERVATION DIVISION
Wichita, Kansas

Describe in detail the manner in which the well was plugged, indicating where the mud fluid was placed and the method or methods used in introducing it into the hole. If cement or other plugs were used, state the character of same and depth placed, _____ feet to _____ feet for each plug set.

4726' - 200' Mud
200' - 196' Plug
196' - 156' Cement, 25 sacks & 1/2 sack hulls
156' - 40' Mud
40' - 36' Plug
36' - 6' Cement, 10 sacks & 1/2 sack hulls
(Bottom of cellar)

(If additional description is necessary, use BACK of this sheet)
Name of Plugging Contractor Lauck Drilling Company, Incorporated
Address 301 S. Broadway, Wichita, Kansas

STATE OF KANSAS COUNTY OF SEDGWICK, ss.

John H. Knightley (employee of owner) or (owner or operator) of the above-described well, being first duly sworn on oath, says: That I have knowledge of the facts, statements, and matters herein contained and the log of the above-described well as filed and that the same are true and correct. So help me God.

(Signature) John H. Knightley
301 S. Broadway, Wichita, Kansas (Address)

SUBSCRIBED AND SWORN TO before me this 6th day of June, 19 67

My commission expires March 12, 1971

Stella J. Lippe
Notary Public.

RECEIVED
STATE CORPORATION COMMISSION
JUN 9 1967
CONSERVATION DIVISION
Wichita, Kansas

D. R. Lauck Oil Company, Inc.

Pelzi #1

NE SE NE Sec. 13-32S-6W
Harper County, Kansas

Commenced: May 17, 1967
Completed: May 31, 1967

Casing Record: 223' 8-5/8" Cemented with 185 sacks Cement,
2% Calcium Chloride.

Elevation: GL 1331; DF 1333; KB 1335.

Drillers Log

Tops

Red Rock	125
Red Bed	223
Shale & Shells	950
Lime & Shale	1275
Shale & Lime	1445
Lime	1835
Shale & Lime	2235
Lime & Shale	2470
Shale & Lime	2640
Lime & Shale	2820
Shale & Lime	3001
Lime & Shale	3150
Shale & Lime	3420
Lime & Shale	3550
Shale	3650
Lime	3891
Lime & Shale	3930
Shale & Lime	4005
Lime & Shale	4125
Shale & Lime	4235
Lime, Shale & Chert	4294
Lime	4310
Lime & Shale	4113
Lime	4597
Shale	4625
Shale & Lime	4699
Lime & Shale	4716
Simpson Sand	4726 RTD

	Sample	Electra
Stalnaker Sand	3430-2095	3434-2099
Kansas City	3650-2315	3652-2317
B.Kansas City	3882-2547	3884-2549
Marmaton	3948-2613	3948-2613
Cherokee	4117-2782	4122-2787
Mississippian	4278-2943	4283-2948
Kinderhook	4597-3262	4608-3273
Simpson	4713-3378	4718-3383
Total Depth	4726-3391	4730-3395

DST #1 (H) 4704-16 (drilling measure-
ments). 4709-21 (Electra
measurements).
Open 1 hour, weak blow 1 hour.
Recovered 30' mud.
 ISIP 1835#/30 min.
 FSIP 1801#/30 min.
 IFP 17#
 FFP 26#

D&A