


STATE OF KANSAS
STATE CORPORATION COMMISSION

Form CP-4

WELL PLUGGING RECORD

Give All Information Completely
Make Required Affidavit
Mail or Deliver Report to:
Conservation Division
State Corporation Commission
P. O. Box 17027
Wichita, Kansas 67217
NORTH

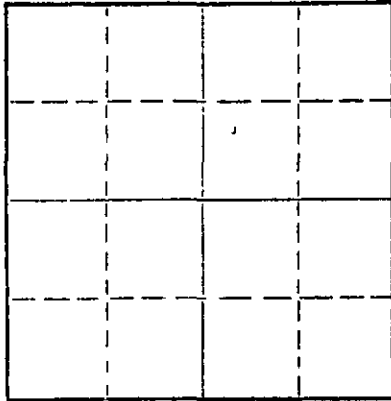

Locate well correctly on above
Section Plat

Harper County, Sec. 10 Twp 32S Rge. (E) 6W (W)
Location as "NE/CNWxSWx" or footage from lines SW NE SW
Lease Owner KEENER OIL COMPANY
Lease Name Mathes Well No. 1
Office Address 406 N.B.T. Bldg., Tulsa, Okla.
Character of Well (completed as Oil, Gas or Dry Hole) Dry Hole
Date well completed 6-29 19 72
Application for plugging filed 6-29 19 72
Application for plugging approved 6-29 19 72
Plugging commenced 6-29 19 72
Plugging completed 6-29 19 72
Reason for abandonment of well or producing formation No commercial quantities of oil or gas encountered.
If a producing well is abandoned, date of last production 19
Was permission obtained from the Conservation Division or its agents before plugging was commenced? yes

Name of Conservation Agent who supervised plugging of this well G. Russel Biberstein
Producing formation Depth to top Bottom Total Depth of Well 4747 Feet
Show depth and thickness of all water, oil and gas formations.

OIL, GAS OR WATER RECORDS

CASING RECORD

| FORMATION | CONTENT | FROM | TO | SIZE | PUT IN | PULLED OUT |
|--------------|---------|---------|------|--------|--------|------------|
| Surface Hole | Water | Surface | 208' | 8-5/8" | 201' | None |

Describe in detail the manner in which the well was plugged, indicating where the mud fluid was placed and the method or methods used in introducing it into the hole. If cement or other plugs were used, state the character of same and depth placed, from feet to feet for each plug set.

Fluid to 350', plug, 40 sx cement;
Fluid to 40', plug, 10 sx cement;
Two sacks cement in rat hole.

RECEIVED
STATE CORPORATION COMMISSION
JUL 5 1972
CONSERVATION DIVISION
Wichita, Kansas

(If additional description is necessary, use BACK of this sheet)

Name of Plugging Contractor D N B DRILLING, INC.
Address 701 First Nat'l Bldg., Wichita, Kansas 67202

STATE OF KANSAS, COUNTY OF ss.
JAMES L. DONELSON (employee of owner) or (owner or operator) of the above-described well, being first duly sworn on oath, says: That I have knowledge of the facts, statements, and matters herein contained and the log of the above-described well as filed and that the same are true and correct. So help me God.

(Signature) James L. Donelson
701 First Nat'l Bldg., Wichita, Ks.
(Address)

SUBSCRIBED AND SWORN TO before me this 3rd day of July, 1972

My commission expires August 25, 1972

Ella Priess Notary Public.

DRILLERS' LOG

KEENER OIL COMPANY
Mathes No. 1
SW NE SW, Sec. 10-32S-6W
Harper County, Kansas

Elev: 1362 K.B.

Commenced: 6-19-72
Completed: 6-29-72

Surface Casing: 201' of
8-5/8" cemented w/225 sx
cement, 3% cc. 6-20-72

FORMATION

DEPTH

| | |
|--------------|------------------|
| Surface Hole | 0 - 208 |
| Shale | 208 - 520 |
| Shale & Lime | 520 - 980 |
| Lime & Shale | 980 - 1128 |
| Shale & Lime | 1128 - 1360 |
| Lime & Shale | 1360 - 3430 |
| Sand | 3430 - 3545 |
| Shale | 3545 - 3710 |
| Lime | 3710 - 3807 |
| Lime & Shale | 3807 - 3924 |
| Lime | 3924 - 4271 |
| Lime & Shale | 4271 - 4310 |
| Lime & Chert | 4310 - 4322 |
| Lime | 4322 - 4632 |
| Lime & Shale | 4632 - 4706 |
| Sand | 4706 - 4729 |
| Lime & Shale | 4729 - 4737 T.D. |

RECEIVED
STATE CORPORATION COMMISSION
JUL 5 1972
CONSERVATION DIVISION
Wichita, Kansas

I do hereby certify that the foregoing statements are true and correct to the best of my knowledge and belief.

D N B DRILLING, INC.

James L. Donelson
JAMES L. DONELSON

STATE OF KANSAS: ss:

Subscribed and sworn to before me, the undersigned, a Notary Public in and for said state, this 3rd day of July, 1972.

My Commission Expires:
August 25, 1972

Ella Priess
Ella Priess, Notary Public