


WELL PLUGGING RECORD

Give All Information Completely
Make Required Affidavit
Mail or Deliver Report to:
Conservation Division
State Corporation Commission
211 No. Broadway
Wichita, Kansas

BARBER County. Sec. 31 Twp. 34S Rge. 12 (X) (W)
Location as "NE/CNW/SW" or footage from lines NW - SE - NW
Lease Owner ATLANTIC RICHFIELD COMPANY
Lease Name NORA E. STERLING Well No. 2
Office Address Box 521, Tulsa, Oklahoma 74102
Character of Well (completed as Oil, Gas or Dry Hole) GAS
Date well completed 8-2- 19 55
Application for plugging filed 10-28- 19 75
Application for plugging approved 11-3- 19 75
Plugging commenced 11-11 19 75
Plugging completed 11-14- 19 75
Reason for abandonment of well or producing formation Depleted

NORTH

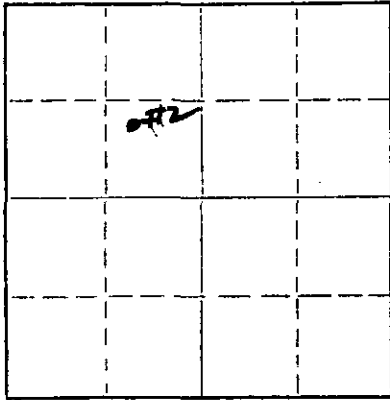

Locate well correctly on above
Section Plat

If a producing well is abandoned, date of last production 4-14- 19 75
Was permission obtained from the Conservation Division or its agents before plugging was commenced? Yes

Name of Conservation Agent who supervised plugging of this well G. Russell Biberstein
Producing formation Burgess Depth to top 4720 Bottom 4760 Total Depth of Well 4890 Feet
Show depth and thickness of all water, oil and gas formations.

OIL, GAS OR WATER RECORDS

CASING RECORD

FORMATION	CONTENT	FROM	TO	SIZE	PUT IN	PULLED OUT
Burgess	Gas	4720	4760	5 1/2	4890	3104
		0	258	10 3/4	258	NONE

Describe in detail the manner in which the well was plugged, indicating where the mud fluid was placed and the method or methods used in introducing it into the hole. If cement or other plugs were used, state the character of same and depth placed, from _____ feet to _____ feet for each plug set.

M.I.C.P.U. pumped in 35 sks cement plug to 4500', shot 5 1/2" csg off at 3316' - 3206 - 3104. Pulled 99 jts 5 1/2" csg, total of 3104. Set 65 sks cement plug at 308 up to 208. Filled hole with mud to 30' of surface, cemented w/15 sks from 25' up to surface. welded plate on top of 10 3/4" csg. Complete P & A 11-14-75.

RECEIVED
STATE CORPORATION COMMISSION

NOV 25 1975
11-25-75
CONSERVATION DIVISION
Wichita, Kansas

(If additional description is necessary, use BACK of this sheet)
Name of Plugging Contractor Lillard Casing Pullers
Address Box 962, Woodward, Oklahoma 73801

STATE OF OKLAHOMA, COUNTY OF WOODWARD, ss.
Doyle Cheatwood (employee of owner) or (owner or operator) of the above-described well, being first duly sworn on oath, says: That I have knowledge of the facts, statements, and matters herein contained and the log of the above-described well as filed and that the same are true and correct. So help me God.

(Signature) Doyle Cheatwood
DOYLE CHEATWOOD
1112 11th, Woodward, Oklahoma 73801
(Address)

SUBSCRIBED AND SWORN TO before me this 17th day of November, 19 75

My commission expires February 28, 1979

Donna Hale
DONNA HALE Notary Public.

15-007-01297-0000

NORA E. STERLING NO. 2

NW/4 of Section 31-34S-12W
Barber County, Kansas
Sinclair Oil and Gas Company

10-3/4" O. D. casing cemented at 258'
5-1/2" O. D. casing cemented at 4890'

Drilling commenced July 17, 1955
Drilling completed August 2, 1955

FROM	TO	FORMATION	REMARKS
0'	70'	Red bed and shale	
70	90	Sand	
90	258	Shale & sand	10-3/4" O. D. casing cemented at 258'
258	950	Red bed and shale	
950	1000	Shale	
1000	1772	Shale and shells	
1772	1840	Anhydrite	
1840	2015	Shale and lime	
2015	2465	Lime and shale	
2465	2590	Shale and lime	
2590	2960	Lime and shale	
2960	3100	Shale and lime	
3100	3180	Lime and shale	
3180	3270	Shale and lime	
3270	3550	Lime and shale	
3550	3695	Shale, lime and sand	
3695	3850	Sand and shale	
3850	3955	Shale	
3955	4030	Lime and shale	
4030	4246	Lime	
4246	4290	Lime and shale	
4290	4395	Shale and lime	
4395	4585	Lime	
4585	4635	Lime and chert	
4635	4790	Lime	
4790	4805	Lime and chert	
4805	4880	Chert and lime	
4880	4890	Lime and chert	5-1/2" O. D. casing cemented with 275 sacks cement at 4890'

RECEIVED
STATE CORPORATION COMMISSION

NOV 3 1975
11-3-75
CONSERVATION DIVISION
Wichita, Kansas

T.D. 4890'

This is a true copy of the driller's log as shown on the drilling tickets.

BARBOUR DRILLING COMPANY

By C. W. Tribel

Subscribed and sworn to before me on this 19th day of August, 1955.

Merry Gene Burt