

STATE OF KANSAS
STATE CORPORATION COMMISSION

Form CP-4

Give All Information Completely
Make Required Affidavit
Mail or Deliver Report to:
Conservation Division
State Corporation Commission
212 No. Market
Wichita, Kansas

WELL PLUGGING RECORD

Barber County, Sec. 28 Twp. 34S Rge. (E) 12 (W)

Location as "NE/CNWxSWx" or footage from lines 664' FWL & 3317' FNL

Lease Owner The Superior Oil Company

Lease Name Graves Unit Well No. 2

Office Address P.O. Box 200, Casper, Wyoming 82601

Character of Well (completed as Oil, Gas or Dry Hole) Gas

Date well completed August 7 19 56

Application for plugging filed July 28 19 71

Application for plugging approved July 30 19 71


Plugging commenced August 23 19 71

Plugging completed August 27 19 71

Reason for abandonment of well or producing formation Depleted

If a producing well is abandoned, date of last production July 30 19 71

Was permission obtained from the Conservation Division or its agents before plugging was commenced? Yes

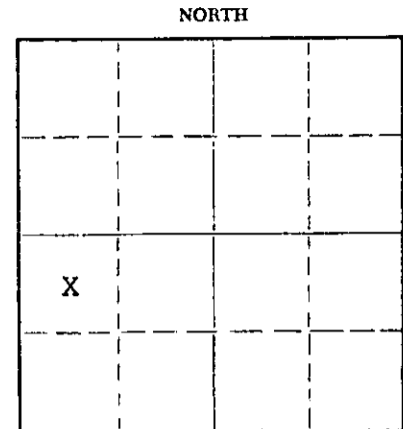

Locate well correctly on above Section Plat

Name of Conservation Agent who supervised plugging of this well Mr. Russell Biberstein

Producing formation Mississippi (Gas) Depth to top 4752 Bottom 4790 Total Depth of Well 4810 Feet

Show depth and thickness of all water, oil and gas formations.

OIL, GAS OR WATER RECORDS

CASING RECORD

FORMATION	CONTENT	FROM	TO	SIZE	PUT IN	PULLED OUT
Mississippi	Gas	4752	4790	10-3/4"	310'	--
				7"	4810'	2893'

Describe in detail the manner in which the well was plugged, indicating where the mud fluid was placed and the method or methods used in introducing it into the hole. If cement or other plugs were used, state the character of same and depth placed, from _____ feet to _____ feet for each plug set.

Dumped 40' sand in hole from 4760' to 4800'. Dumped 7 sacks cement on top of sand - cement from 4720'-4760' (calculated). Loaded hole with 180 bbls. salt water. Shot and recovered 2893' - 7" casing. Ran bailer. Bailed hole to 270'. Put 20' rock bridge from 250' to 270'. Set cement plug from surface to 250'. Cut off 10-3/4" casing 32" below ground level. Welded on cap.

RECEIVED
STATE CORPORATION COMMISSION
SEP 7 1971
CONSERVATION DIVISION
Wichita, Kansas

(If additional description is necessary, use BACK of this sheet)
Name of Plugging Contractor Knight Casing Pulling Co., Inc.
Address P. O. Box 405, Chase, Kansas 67524

STATE OF WYOMING, COUNTY OF NATRONA, ss.
Herman High (employee of owner) or (owner or operator) of the above-described

well, being first duly sworn on oath, says: That I have knowledge of the facts, statements, and matters herein contained and the log of the above-described well as filed and that the same are true and correct. So help me God.

(Signature) Herman High District Engineer
P. O. Box 200, Casper, Wyoming 82601
(Address)

SUBSCRIBED AND SWORN TO before me this 3rd day of September, 19 71

My commission expires September 9, 1973
J. R. Voris Notary Public.