


Give All Information Completely  
Make Required Affidavit  
Mail or Deliver Report to:  
Conservation Division  
State Corporation Commission  
211 No. Broadway  
Wichita, Kansas

WELL PLUGGING RECORD

Barber County. Sec. 26 Twp. 34S Rge. 12W (E) (W)  
Location as "NE/CNWSW" or footage from lines Ctr. SW NE  
Lease Owner Texaco Inc.  
Lease Name F. E. Stranathan Well No. 1  
Office Address 614 Bitting Bldg., Wichita, Kansas  
Character of Well (completed as Oil, Gas or Dry Hole) Dry Hole  
Date well completed 3-27 1963  
Application for plugging filed 3-27 1963  
Application for plugging approved 3-27 1963  
Plugging commenced 3-27 1963  
Plugging completed 3-27 1963  
Reason for abandonment of well or producing formation Dry Hole

NORTH

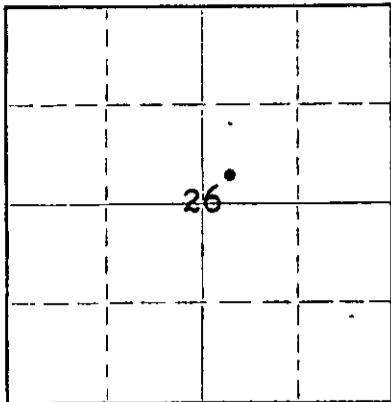

Locate well correctly on above  
Section Plat

If a producing well is abandoned, date of last production Dry Hole 19\_\_  
Was permission obtained from the Conservation Division or its agents before plugging was commenced? Yes

Name of Conservation Agent who supervised plugging of this well Archie Elving Pratt, Kansas  
Producing formation Dry Hole Depth to top \_\_\_\_\_ Bottom \_\_\_\_\_ Total Depth of Well 4800 Feet  
Show depth and thickness of all water, oil and gas formations.

OIL, GAS OR WATER RECORDS

CASING RECORD

FORMATION	CONTENT	FROM	TO	SIZE	PUT IN	PULLED OUT
<u>Dry Hole</u>				<u>8-5/8"</u>	<u>261</u>	<u>None</u>

Describe in detail the manner in which the well was plugged, indicating where the mud fluid was placed and the method or methods used in introducing it into the hole. If cement or other plugs were used, state the character of same and depth placed, from \_\_\_\_\_ feet to \_\_\_\_\_ feet for each plug set.

Hole plugged as follows: Heavy mud 4800-240', 35 sacks cement 240-185', Heavy mud 185-40', 10 sacks cement 40-3'. Plugged rat hole with 5 sacks cement.

RECEIVED  
STATE CORPORATION COMMISSION

APR 8 1963  
4-8-63

CONSERVATION DIVISION  
Wichita, Kansas

(If additional description is necessary, use BACK of this sheet)  
Name of Plugging Contractor Prime Drilling Company  
Address 814 Union Center Bldg., Wichita, Kansas

STATE OF Kansas, COUNTY OF Sedgwick, ss.  
H. N. Wade (employee of owner) ~~XXXXXX~~ of the above-described well, being first duly sworn on oath, says: That I have knowledge of the facts, statements, and matters herein contained and the log of the above-described well as filed and that the same are true and correct. So help me God.

(Signature) [Signature]  
614 Bitting Bldg., Wichita, Kansas  
(Address)

SUBSCRIBED AND SWORN to before me this 3 day of April, 19 63

My commission expires 6-20-64  
A.E. Boyd  
Notary Public.

15-007-00687-0000

ROTARY DRILLING LOG

OWNER: Texaco, Inc.  
 CONTRACTOR: Prime Drilling Company  
 LEASE: F. E. Stranathan #1  
 LOCATION: C SW NE Sec. 26-348-12W  
 Barber County, Kansas

CASING: Set 8 5/8" surface casing  
 @ 261', 200 sz Pozmix,  
 2% c.c.

0 - 796	Red Bed & Shale
796 - 1050	Shale
1050 - 1340	Shale & Lime
1340 - 1550	Shale
1550 - 1625	Shale & Anhydrite
1625 - 1885	Lime & Shale
1885 - 2010	Shale & Lime
2010 - 2150	Shale & Lime Streaks
2150 - 2300	Lime & Shale
2300 - 2400	Shale & Lime
2400 - 2595	Shale & Lime Streaks
2595 - 2802	Lime & Shale
2802 - 2975	Shale & Lime
2975 - 3065	Lime & Shale
3065 - 3290	Lime & Shale Streaks
3290 - 3319	Shale & Lime
3319 - 3361	Lime
3361 - 3486	Shale & Lime
3486 - 3605	Lime & Shale
3605 - 3885	Sand & Shale
3885 - 3962	Lime & Shale
3962 - 4075	Shale, Lime & Sand
4075 - 4125	Core #1
4125 - 4150	Shale & Lime
4150 - 4250	Lime & Shale Streaks
4250 - 4266	Shale & Lime
4266 - 4273	Lime
4273 - 4330	Shale & Lime
4330 - 4383	Lime & Chert
4383 - 4428	Cherty Lime
4428 - 4605	Lime
4605 - 4612	Black Shale
4612 - 4646	Cherty Lime
4646 - 4679	Shale & Lime
4679 - 4689	Sand
4689 - 4710	Lime
4710 - 4735	Sand, Chert & Lime
4735 - 4670	Mississippi Lime
4670 - 4800	Lime
4800	Rotary Total Depth

D & A

RECEIVED  
 STATE CORPORATION COMMISSION

APR 8 1963  
 4-8-63  
 CONSERVATION DIVISION  
 WICHITA, KANSAS

We certify that the above log is true and correct to the best of our knowledge and belief.

PRIME DRILLING COMPANY

BY R. R. McNicol  
 R. R. McNicol