


STATE OF KANSAS  
STATE CORPORATION COMMISSION

Give All Information Completely  
Make Required Affidavit  
Mail or Deliver Report to:  
Conservation Division  
State Corporation Commission  
211 No. Broadway  
Wichita, Kansas

WELL PLUGGING RECORD

CP

NORTH

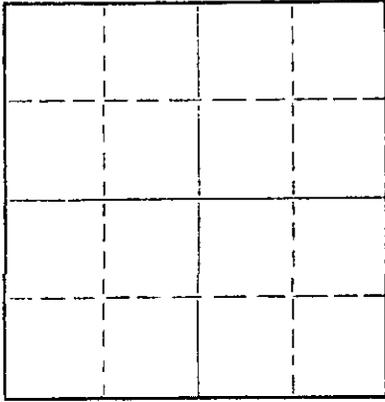

Locate well correctly on above  
Section Plat

Barber County. Sec. 10 Twp. 34S Rge. (E) 15W (W)  
Location as "NE/CNW&SW" or footage from lines C NE NE  
Lease Owner K & E DRILLING, INC.  
Lease Name Davis Ranch "A" Well No. 1  
Office Address 719 Union Center, Wichita 2, Kansas  
Character of Well (completed as Oil, Gas or Dry Hole) dry hole  
Date well completed 4-14-64 19  
Application for plugging filed 4-14-64 19  
Application for plugging approved 4-14-64 19  
Plugging commenced 4-14-64 19  
Plugging completed 4-14-64 19  
Reason for abandonment of well or producing formation dry

If a producing well is abandoned, date of last production \_\_\_\_\_ 19  
Was permission obtained from the Conservation Division or its agents before plugging was commenced? yes

Name of Conservation Agent who supervised plugging of this well A. Elving, Pratt Kansas  
Producing formation \_\_\_\_\_ Depth to top \_\_\_\_\_ Bottom \_\_\_\_\_ Total Depth of Well 4926 Feet  
Show depth and thickness of all water, oil and gas formations.

OIL, GAS OR WATER RECORDS

CASING RECORD

FORMATION	CONTENT	FROM	TO	SIZE	PUT IN	PULLED OUT
				10-3/4"	245'	-0-

Describe in detail the manner in which the well was plugged, indicating where the mud fluid was placed and the method or methods used in introducing it into the hole. If cement or other plugs were used, state the character of same and depth placed, from \_\_\_\_\_ feet to \_\_\_\_\_ feet for each plug set.

Heavy mud to 240' with 1 sack hulls & plug with 30 sacks cement.  
Heavy mud to 40', solid bridge and 15 sacks cement  
Plugged @ 4:45 a.m. April 14, 1964

**RECEIVED**  
STATE CORPORATION COMMISSION  
4-17-64  
APR 17 1964

CONSERVATION DIVISION  
Wichita, Kansas

(If additional description is necessary, use BACK of this sheet)

Name of Plugging Contractor K & E DRILLING, INC.  
Address K & E DRILLING, Inc., 719 Union Center, Wichita, Kansas

STATE OF Kansas COUNTY OF Sedgwick, ss.  
H. L. Wilson (employee of owner) or XXXXXXXXXX (owner or operator) of the above-described well, being first duly sworn on oath, says: That I have knowledge of the facts, statements, and matters herein contained and the log of the above-described well as filed and that the same are true and correct. So help me God.

(Signature) H. L. Wilson  
719 Union Center, Wichita  
(Address)

SUBSCRIBED AND SWORN to before me this 16th day of April, 19 64  
Julene M. Bannon  
Julene M. Bannon Notary Public.

My commission expires August 30, 1965



R

# DRILLER'S WELL LOG

OPERATOR: K & E DRILLING, INC.  
719 Union Center Building  
Wichita 2, Kansas

WELL NAME: #1 Davis Ranch "A"  
LOCATION: C NE NE  
Sec. 10-34S-15W  
Barber County, Kansas

CONTRACTOR: K & E DRILLING, INC.  
719 UNION CENTER BLDG.  
WICHITA, KANSAS

COMMENCED: April 1, 1964

CASING RECORD: 10-3/4" @ 245' with 200 sx.

COMPLETED: April 13, 1964

ROTARY TOTAL DEPTH: 4926'

ELEVATION: 1715 D.F.

PRODUCTION: 1718 K.B.  
D & A

## FORMATION RECORD

Depths shown indicate bottom of formations encountered.

Sand	190
Red Bed	1160
Shale & Shells	1500
Shale & Lime	2000
Lime	2481
Lime & Shale	2578
Lime	2709
Lime & Shale	2983
Lime	4926

RECEIVED  
STATE CORPORATION COMMISSION

APR 17 1964

CONSERVATION DIVISION  
Wichita, Kansas

## CERTIFICATION

State of KANSAS }  
County of SEDGWICK } ss:

I, Wayne L. Brinegar, of K&E DRILLING, INC., upon oath state that the above and foregoing is a true and correct copy of the Driller's Log of the above named well.

Wayne L. Brinegar  
Wayne L. Brinegar

Subscribed and sworn to before me this 16th day of April, 1964.

Jylene M. Bannon  
Jylene M. Bannon Notary Public.

My Commission expires: August 30, 1965

