


Give All Information Completely
Make Required Affidavit
Mail or Deliver Report to:
Conservation Division
State Corporation Commission
212 No. Market
Wichita, Kansas

WELL PLUGGING RECORD

NORTH

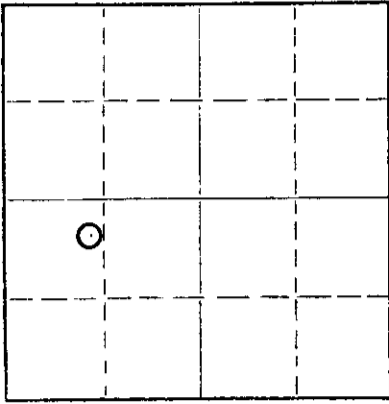

Locate well correctly on above
Section Plat

Barber County, Sec. 31 Twp. 34S Rge. (E) 15 (W)
Location as "NE/CNW/SE/SW" or footage from lines 2340' FSL & 1220' FWL
Lease Owner Midwest Oil Corporation
Lease Name Ballet Ranch Well No. 9
Office Address 1418 Liberty Bank Bldg., Oklahoma City, Okla. 73102
Character of Well (completed as Oil, Gas or Dry Hole) Dry Hole
Date well completed May 8, 19 67
Application for plugging filed Attached 19
Application for plugging approved May 11, 19 67
Plugging commenced May 8, 19 67
Plugging completed May 8, 19 67
Reason for abandonment of well or producing formation Dry Hole

If a producing well is abandoned, date of last production - 19
Was permission obtained from the Conservation Division or its agents before plugging was commenced? Yes

Name of Conservation Agent who supervised plugging of this well Mr. A. Elving
Producing formation None Depth to top Bottom Total Depth of Well 5025' Feet
Show depth and thickness of all water, oil and gas formations.

OIL, GAS OR WATER RECORDS

CASING RECORD

FORMATION	CONTENT	FROM	TO	SIZE	PUT IN	PULLED OUT
				8-5/8"	1028'	None

Describe in detail the manner in which the well was plugged, indicating where the mud fluid was placed and the method or methods used in introducing it into the hole. If cement or other plugs were used, state the character of same and depth placed, from feet to feet for each plug set.

- 50 sacks cement plug set at 5025' TD
- 15 sacks cement plug set at 1080'
- 25 sacks cement plug set at 540'
- 10 sacks cement plug set at surface

RECEIVED
MAY 22 1967
CONSERVATION DIVISION
Wichita, Kansas

(If additional description is necessary, use BACK of this sheet)

Name of Plugging Contractor Stickle Drilling Company
Address 1100 Bitting Building, Wichita, Kansas

STATE OF OKLAHOMA, COUNTY OF OKLAHOMA, ss.
Neil G. Owens (employee of owner) or (owner or operator) of the above-described well, being first duly sworn on oath, says: That I have knowledge of the facts, statements, and matters herein contained and the log of the above-described well as filed and that the same are true and correct. So help me God.

(Signature) Neil G. Owens
1418 Liberty Bank Building
(Address)

SUBSCRIBED AND SWORN TO before me this 19th day of May, 1967

My commission expires October 14, 1968 Notary Public.

Midwest Oil Corporation
Fort Worth, Texas

Drlg. Contractor: Stickle Drilling Company
Date Commenced: 24 April 1967
Date Completed: 8 May 1967

Ballet Ranch No. 9
2340' FSL & 1220' FWL
Section 31-34S-15W
Barber County, Kansas

DRILLER'S LOG


Depth figures indicate base of formation:

Red Bed	1028
Shale	1300
Shale and Shells	1940
Shale	2203
Shale and Lime	2275
Lime	2454
Lime and Shale	2755
Shale and Lime	3056
Lime and Shale	3153
Shale and Lime	3340
Shale, Lime and Sand	3648
Shale and Lime	4222
Lime and Shale	4565
Lime	4593
Lime and Chert	4630
Lime	5012
Lime and Chert	5025 RTD

I, R. B. Parriott, hereby certify that to the best of my knowledge and belief, the above is a true and complete Driller's Log of Midwest Oil Corporation's Ballet Ranch No. 9 in Barber County, Kansas.



R. B. Parriott

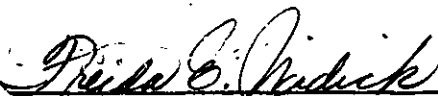

Freida E. Widick, Notary Public
My Commission Expires 23 June 1970

RECEIVED
STATE CORPORATION COMMISSION

MAY 22 1967

CONSERVATION DIVISION
Wichita, Kansas