

STATE OF KANSAS
STATE CORPORATION COMMISSION
200 Colorado Derby Building
Wichita, Kansas 67202

WELL PLUGGING RECORD
K.A.R.-82-3-117

API NUMBER 15-007-20,918-00-00

LEASE NAME Ballet Ranch

WELL NUMBER #1

 Ft. from S Section Line

 Ft. from E Section Line

SEC. 31 TWP. 34 SRGE. 15 NE or (W)

COUNTY Barber

Date Well Completed

Plugging Commenced 11-19 9:45

Plugging Completed 11-19 10:35

TYPE OR PRINT
NOTICE: Fill out completely
and return to Cons. Div.
office within 30 days.

LEASE OPERATOR TXO Production Corp.

ADDRESS 155 N. Market, Suite 1000, Wichita, Ks.

PHONE# (316) 269-7600 OPERATORS LICENSE NO. 5171

Character of Well Gas

(Oil, Gas, D&A, SWD, Input, Water Supply Well)

Did you notify the KCC/KDHE Joint District Office prior to plugging this well? yes

Which KCC/KDHE Joint Office did you notify? District #1

Is ACO-1 filed? yes if not, is well log attached?

Producing Formation Depth to Top 4754 Bottom 4764 T.D. 5096

Show depth and thickness of all water, oil and gas formations.

OIL, GAS OR WATER RECORDS

CASING RECORDS

Formation	Content	From	To	Size	Put in	Pulled
				8 5/8	943	
				4 1/2	5096	

RECEIVED
STATE CORPORATION COMMISSION
OIL & GAS DIVISION
WICHITA, KANSAS
11-30-87

Describe in detail the manner in which the well was plugged, indicating when the mud fluid was placed and the method or methods used in introducing it into the hole. If cement or other plugs were used, state the character of same and depth placed, from feet to feet each set.

Bottom: 2 hulls, 20 sks class A cmt. Top: 3 hulls, 10 gel, 50 cmt.
10 gel, 1 hull, plug, 125 cmt. 900# Max. Shut in 400

(If additional description is necessary, use BACK of this form.)

Name of Plugging Contractor Great Bend Casing Pullers, Inc. License No. 4635 CP

Address Box 768, Great Bend, Kansas 67530

STATE OF Kansas COUNTY OF Barton, ss.

Randy P. Wagner (Employee of Operator) or (Operator) of above-described well, being first duly sworn on oath, says: That I have knowledge of the facts, statements, and matters herein contained and the log of the above-described well as filed that the same are true and correct, so help me God.


(Signature) Randy P. Wagner

(Address) Box 768, Great Bend, Kansas

67540

SUBSCRIBED AND SWORN TO before me this 25 day of November, 19 87

Louella L. Goullin
Notary Public

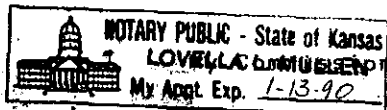

Expires: 1-13-90

KANSAS DRILLERS LOG

IMPORTANT
 Kans. Geo. Survey request
 samples on this well.


API No. 15 — 007 — 20,918
County Number

S. 31 T. 34 R. 15 ^N _W

Loc. C S2 SW

County Barber

640 Acres
N

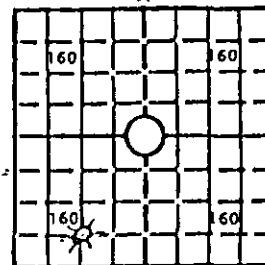

Locate well correctly

Elev.: Gr. 1692

DF _____ KB 1700'

Operator Texas Oil & Gas Corp.

Address 200 W. Douglas, Suite 300 Wichita, Kansas 67202

Well No. # 1 Lease Name Ballet Ranch

Footage Location
660' feet from XX (S) line 1320' feet from XX (W) line

Principal Contractor Xplor, Rig #1 Geologist N/A

Spud Date 4-24-80 Total Depth 5100' P.B.T.D. 5067'

Date Completed 6-11-80 Oil Purchaser N/A

CASING RECORD

Report of all strings set — surface, intermediate, production, etc.

Purpose of string	Size hole drilled	Size casing set (in O.D.)	Weight lbs/ft.	Setting depth	Type cement	Sacks	Type and percent additives
Surface	12 1/4"	8-5/8"		943'		200	
Production		4-1/2"	10.5#	5096'		150	

G E O L . F I L E

LINER RECORD

PERFORATION RECORD

Top, ft. N/A	Bottom, ft. N/A	Sacks cement N/A	Shots per ft. 1 JSPF	Size & type Miss.	Depth Interval 4996-5002' & 5010-5022'
TUBING RECORD					
Size 2-3/8" & 2-3/8"	Setting depth 5002' & 4937'	Packer set at			

ACID, FRACTURE, SHOT, CEMENT SQUEEZE RECORD

Amount and kind of material used	Depth Interval treated
Dumped 250 gals 15% DeMud acid across perfs	4996-5002 & 5010-5022'
Acidized w/1000 gals 15% HCl + 230,000 scf N ₂ @ 8 BPM	" "
Fraced w/40,000# sand, 580,000 scf N ₂ & 11,760 gals gelled wtr in 70-quality foam @ 16 BPM	" "

RECEIVED
 STATE COMMISSION

INITIAL PRODUCTION

Date of first production 1-28-81 Producing method (flowing, pumping, gas lift, etc.) flowing

RATE OF PRODUCTION PER 24 HOURS
 Oil N/A Gas 294 MCFD Water 42 BW in 24 hrs
bbls. MCF bbls. CFPB

Disposition of gas (vented, used on lease or sold) Delhi Gas Pipeline Producing interval (s) 4996-5002 & 5010-5022'

INSTRUCTIONS: As provided in KCC Rule 82-2-125, within 90 days after completion of a well, one completed copy of this Drillers Log shall be transmitted to the State Geological Survey of Kansas, 4150 Monroe Street, Wichita, Kansas 67209. Copies of this form are available from the Conservation Division, State Corporation Commission, 3830 So. Meridian (P.O. Box 17027), Wichita, Kansas 66217. Phone AC 316-522-2206. If confidential custody is desired, please note that this log will be on confidential file in the Oil and Gas Division, State Geological Survey of Kansas, Lawrence, Kansas 66044.