

Give All Information Completely
Make Required Affidavit
Mail or Deliver Report to:
Conservation Division
State Corporation Commission
212 No. Market
Wichita, Kansas

WELL PLUGGING RECORD

Barber County, Sec. 29 Twp. 34S Rge. (E)15W (W)

Location as "NE/CNW/SW" or footage from line: 100' S of C SW/4

Lease Owner: Midwest Oil Corporation

Lease Name: W. W. Winters Well No. 1

Office Address: 1418 Liberty Bank Building, Oklahoma City, Oklahoma

Character of Well (completed as Oil, Gas or Dry Hole): Dry Hole

Date well completed: March 19, 19 68

Application for plugging filed: Attached 19

Application for plugging approved: March 26, 19 68


Plugging commenced: March 19 19 68

Plugging completed: March 19 19 68

Reason for abandonment of well or producing formation: Dry Hole

If a producing well is abandoned, date of last production: - - 19

Was permission obtained from the Conservation Division or its agents before plugging was commenced? Yes

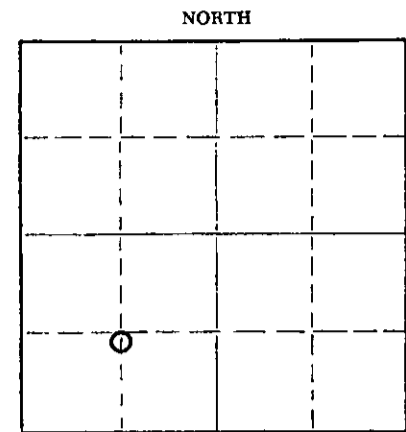

Locate well correctly on above Section Plat

Name of Conservation Agent who supervised plugging of this well: Herman Justus

Producing formation: None Depth to top: Bottom: Total Depth of Well: 4950' Feet

Show depth and thickness of all water, oil and gas formations.

OIL, GAS OR WATER RECORDS

CASING RECORD

FORMATION	CONTENT	FROM	TO	SIZE	PUT IN	PULLED OUT
				8-5/8" Csg.	1005'	None

Describe in detail the manner in which the well was plugged, indicating where the mud fluid was placed and the method or methods used in introducing it into the hole. If cement or other plugs were used, state the character of same and depth placed, from feet to feet for each plug set.

50 sacks cement plug set at 4750-4900'

50 sacks cement plug set at 4050-4200'

50 sacks cement plug set at 900-1050'

25 sacks cement plug set in top of surface casing.

RECEIVED
STATE CORPORATION COMMISSION
MAR 29 1968
CONSERVATION DIVISION
Wichita, Kansas

(If additional description is necessary, use BACK of this sheet)

Name of Plugging Contractor: Bowers Drilling Company, Inc.
Address: Wichita Plaza Bldg., Wichita, Kansas 67202

STATE OF Oklahoma, COUNTY OF Oklahoma, ss.
Neil G. Owens (employee of owner) or (owner/operator) of the above-described

well, being first duly sworn on oath, says: That I have knowledge of the facts, statements, and matters herein contained and the log of the above-described well as filed and that the same are true and correct. So help me God.

(Signature) *Neil G. Owens*

1418 Liberty Bk. Bldg., Oklahoma City, Okla.
(Address)

SUBSCRIBED AND SWORN TO before me this 28th day of March, 19 68

Pat Pruitt

My commission expires October 14, 1968

Notary Public.

WELL LOG

COMPANY: Midwest Oil Corporation
CONTRACTOR: Bowers Drilling Company, Inc.
FARM: W. W. Winters No. 1
LOCATION: 100' S. of C SW Sec. 29-34S-15W
Barber County, Kansas
COMMENCED: 3-8-68
COMPLETED: 3-19-68
ELEVATION:

0 - 1005	Shale & Redbed	
1005 - 1770	Shale & Shells	Set 8-5/8" casing at 1005 W/500 sacks
1770 - 2089	Lime & Shale	
2089 - 2775	Lime	
2775 - 4355	Lime & Shale	
4355 - 4797	Lime	
4797 - 4840	Lime & Shale	
4840 - 4875	Lime & Chert	
4875 - 4950	Lime & Shale	
4950 -	T.D.	D & A

LOG TOPS

RECEIVED
STATE CORPORATION COMMISSION
MAR 29 1968
CONSERVATION DIVISION
Wichita, Kansas

STATE OF KANSAS)
) SS
COUNTY OF SEDGWICK)

I, Emil E. Bowers, do hereby certify that the above and foregoing is a true and correct copy of the log of the W. W. Winters No. 1 located 100' South of C SW Section 29-34S-15W Barber County, Kansas, as reflected by the files of Bowers Drilling Company, Inc.



Emil E. Bowers
Emil E. Bowers, President

Subscribed and sworn to before me, a Notary Public, in and for the State of Kansas this 27th day of March, 1968.

Elaine Reichenberger
Elaine Reichenberger Notary Public

My commission expires November 16, 1971.