


Give All Information Completely  
Make Required Affidavit  
Mail or Deliver Report to:  
Conservation Division  
State Corporation Commission  
211 No. Broadway  
Wichita, Kansas

WELL PLUGGING RECORD

Barber County. Sec. 28 Twp. 34S Rge. (E) 15 (W)  
Location as "NE/CNW/SW" or footage from lines SE/4  
Lease Owner F.C.D. Oil Corporation  
Lease Name Leanore Well No. 2-28  
Office Address 2200 NW 50th, Suite 200, OKC, OK 73112  
Character of Well (completed as Oil, Gas or Dry, Hole) (Dry, Hole)  
Date well completed July 22 1982  
Application for plugging filed April 7 1982  
Application for plugging approved April 12 1982  
Plugging commenced July 1, 19 82  
Plugging completed July 22, 19 82  
Reason for abandonment of well or producing formation Dry

If a producing well is abandoned, date of last production - 19  
Was permission obtained from the Conservation Division or its agents before plugging was commenced? Yes

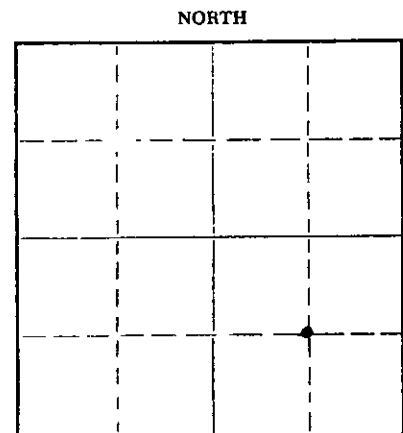

Locate well correctly on above Section Plat

Name of Conservation Agent who supervised plugging of this well Mr. Leslie  
Producing formation Mississippi Depth to top 4746 Bottom 4930 Total Depth of Well 4930 Feet  
Show depth and thickness of all water, oil and gas formations.

OIL, GAS OR WATER RECORDS

CASING RECORD

FORMATION	CONTENT	FROM	TO	SIZE	PUT IN	PULLED OUT
Kansas City Lansing	Oil & gas	4140	4510	8-5/8"	810'	None
Oswego	Oil & gas	4520	4595	4-1/2"	4930'	1532.38'
Mississippi	Oil & gas	4746	TD			

Describe in detail the manner in which the well was plugged, indicating where the mud fluid was placed and the method or methods used in introducing it into the hole. If cement or other plugs were used, state the character of same and depth placed, from feet to feet for each plug set.

A 35 sack cement plug was pumped to 4000 feet with mud laden fluid.

Pipe was shot free at 1520 feet and pulled.

Pumped 150 sack cement plug, to 450'.

Capped surface pipe with 25 sack cement plug from 33 feet to 3 feet.

Cut off surface pipe and welded on steel plate.

Name of Plugging Contractor Reeves & Wilson, Inc. (If additional description is necessary, use BACK of this sheet)  
Address P. O. Box 94204, Oklahoma City, Oklahoma 73143

STATE OF Oklahoma, COUNTY OF Oklahoma, ss.  
Jeff Hume (employee of owner) or (owner or operator) of the above-described well, being first duly sworn on oath, says: That I have knowledge of the facts, statements, and matters herein contained and the log of the above-described well as filed and that the same are true and correct. So help me God.

(Signature) [Signature]  
2200 NW 50th, Suite 200 OKC, OK 73112 (Address)

SUBSCRIBED AND SWORN to before me this 15th day of September

RECEIVED  
STATE CORPORATION COMMISSION  
Notary Public.  
SEP 16 1982

My commission expires 3/3/84

# WELL LOG

*File*

COMPANY FCD Oil Corporation

SEC. 28 T. 34S R. 15W

FARM Leanore

NO. 2-28

LOG. CME


TOTAL DEPTH 4930 RTD

COUNTY Barber, Kansas

COMM. 12-9-80

COMP. 12-18-80

CONTRACTOR DaMac Drilling Inc.

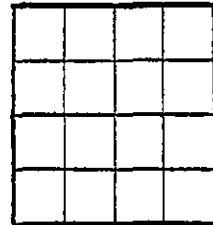

CASING 8 5/8 set @ 77

ELEVATION

PRODUCTION 4 1/2 set @ 4930

FIGURES INDICATE BOTTOM OF FORMATIONS

Surface Sand	0	250
RedBed, Shale	250	810
Shale	810	1062
Shale, Lime	1062	4930 RTD

RECEIVED  
 STATE CORPORATION COMMISSION  
 APR - 9 1980  
 CONSERVATION DIVISION  
 Wichita, Kansas

State of Kansas }  
 County of Barton } ss

I, Martha J. McKown of DaMac Drilling Inc.

upon oath state the above and foregoing is a true and correct copy of the log of the Leanore 2-28 well.

*Martha J. McKown*

Subscribed and sworn to before me this 22nd day of Dec. 19 80

My Commission Expires: \_\_\_\_\_

*Vada*  
 NOTARY PUBLIC  
 VADA I. SULLIVAN  
 Barton County, Kansas  
 My Appt. Exp. 30-84