


Give All Information Completely
Make Required Affidavit
Mail or Deliver Report to:
Conservation Division
State Corporation Commission
211 No. Broadway
Wichita, Kansas

WELL PLUGGING RECORD

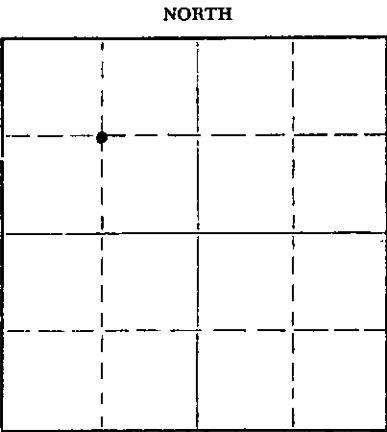

Locate well correctly on above
Section Plat

Barber County. Sec. 28 Twp. 34S Rge. (E) 15 (W)
Location as "NE/CNW/SW" or footage from lines C NW/4
Lease Owner F.C.D. Oil Corporation
Lease Name Ballet Ranch Well No. 1-28
Office Address 2200 NW 50th, Suite 200 OKC, OK 73112
Character of Well (completed as Oil, Gas or Dry Hole) Oil, Gas or Dry Hole
Date well completed July 22, 1982
Application for plugging filed April 7, 1982
Application for plugging approved April 12, 1982
Plugging commenced June 30, 1982
Plugging completed July 22, 1982
Reason for abandonment of well or producing formation Dry

If a producing well is abandoned, date of last production --- 19
Was permission obtained from the Conservation Division or its agents before plugging was commenced? Yes

Name of Conservation Agent who supervised plugging of this well Mr. Leslie
Producing formation Mississippi Depth to top 4780 Bottom 4899 Total Depth of Well 4899 Feet
Show depth and thickness of all water, oil and gas formations.

OIL, GAS OR WATER RECORDS

CASING RECORD

FORMATION	CONTENT	FROM	TO	SIZE	PUT IN	PULLED OUT
Kansas City Lansing	Oil & Gas	4160	4540	8-5/8"	376'	None
Oswego	Oil & Gas	4550	4620	4-1/2"	4899'	2346.33'
Mississippi	Oil & Gas	4780	4899			

Describe in detail the manner in which the well was plugged, indicating where the mud fluid was placed and the method or methods used in introducing it into the hole. If cement or other plugs were used, state the character of same and depth placed, from _____ feet to _____ feet for each plug set.

A 35 sack cement plug was pumped to 3940 feet with mud laden fluid.

Pipe was shot free at 2300 feet and pulled.

Pumped 150 sack cement plug to 450'.

Capped surface pipe with 25 sack cement plug from 33 feet to 3 feet.

Cut off surface pipe and welded on steel plate.

(If additional description is necessary, use BACK of this sheet)
Name of Plugging Contractor Reeves & Wilson, Inc.
Address P. O. Box 94204, Oklahoma City, Oklahoma 73143

STATE OF Oklahoma, COUNTY OF Oklahoma, ss.
Jeff Hume (employee of owner) or (owner or operator) of the above-described

well, being first duly sworn on oath, says: That I have knowledge of the facts, statements and matters herein contained and the log of the above-described well as filed and that the same are true and correct. So help me God.

(Signature) [Signature]

2200 NW 50th, Suite 200 OKC (Address)

SUBSCRIBED AND SWORN to before me this 15th day of September, 1982

My commission expires 3/3/84

RECEIVED
STATE CORPORATION COMMISSION
SEP 16 1982
Notary Public
CONSERVATION DIVISION
Wichita, Kansas

WELL LOG

COMPANY FCD Oil Corporation

SEC. 28 T. 34S R. 15W

FARM Ballet NO. 1-28


LOC. C. NE

TOTAL DEPTH 4899'

COUNTY Barber, Kansas

COMM. 11-27-80 COMP. 12-7-80

CONTRACTOR DaMac Drilling Inc.

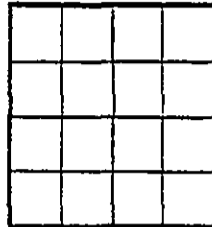

CASING Conductor: 20" set @ 70'
Surface: 8 5/8 set @ 325'

ELEVATION

PRODUCTION 4 1/2 set @ 4898

FIGURES INDICATE BOTTOM OF FORMATIONS

Surface Sand	0	70
RedBed	70	907
Shale	907	1742
Lime, Shale	1742	4899 RTD

RECEIVED
 STATE CORPORATION COMMISSION
APR - 9 1982
 CONSERVATION DIVISION
 Wichita, Kansas

State of Kansas }
 County of Barton } ss

I, Martha J. McKown of DaMac Drilling Inc.

upon oath state the above and foregoing is a true and correct copy of the log of the Ballet 1-28 well.

Subscribed and sworn to before me this 7th day of December 19 80

My Commission Expires:

RANDALL SULLIVAN
 Barton County, Kansas
 My Appt. Exp. 1-30-84

Vada J. Sullivan
 NOTARY PUBLIC