

STATE OF KANSAS
STATE CORPORATION COMMISSION


WELL PLUGGING RECORD

Give All Information Completely
Make Required Affidavit
Mail or Deliver Report to:
Conservation Division
State Corporation Commission
211 No. Broadway
Wichita, Kansas

Barber County, Sec. 27 Twp. 34 Rge. (E) 15 (W)

Location as "NE/CNW/SW" or footage from lines NE/4, NW/4
Lease Owner William Gruenerwald
Lease Name Ballet Well No. 1
Office Address 35 East Wacker Drive Chicago 1, Ill.
Character of Well (completed as Oil, Gas or Dry Hole) Dry Hole
Date well completed December 8th 19 56
Application for plugging filed December 7th 19 56
Application for plugging approved December 7th 19 56
Plugging commenced December 7th 19 56
Plugging completed December 7th 19 56
Reason for abandonment of well or producing formation

NORTH

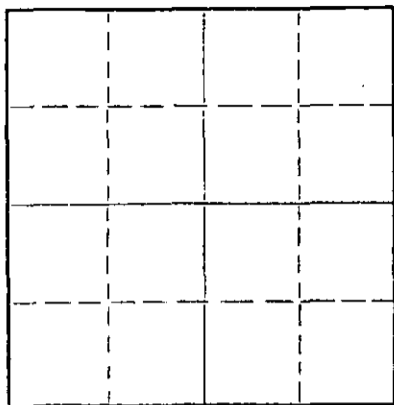

Locate well correctly on above
Section Plat

If a producing well is abandoned, date of last production 19
Was permission obtained from the Conservation Division or its agents before plugging was com-
menced? Yes

Name of Conservation Agent who supervised plugging of this well M. A. Rives
Producing formation Depth to top Bottom Total Depth of Well 5500 Feet
Show depth and thickness of all water, oil and gas formations.

OIL, GAS OR WATER RECORDS

CASING RECORD

FORMATION	CONTENT	FROM	TO	SIZE	PUT IN	PULLED OUT
				13 3/8"	75'	None
				8 5/8"	824'	None

Describe in detail the manner in which the well was plugged, indicating where the mud fluid was placed and the method or methods used in introducing it into the hole. If cement or other plugs were used, state the character of same and depth placed, from feet to feet for each plug set.

Filled hole with Heavy Mud to 300', Set Bridge Plug at 300' Cemented thru Drill pipe with 20 sacks cement and filled hole with Heavy Mud to 35' and set Bridge Plug at 35' and Cemented with 10 Sacks Cement.

(If additional description is necessary, use BACK of this sheet)

Name of Plugging Contractor Drilling Contractor, Patten Drilling Company, Inc.
Address 505 Opheum Bldg. Wichita 2, Kansas.

STATE OF Kansas COUNTY OF Sedgwick ss.

Robert W. Patten (employee of owner) or (owner or operator) of the above-described well, being first duly sworn on oath, says: That I have knowledge of the facts, statements, and matters herein contained and the log of the above-described well as filed and that the same are true and correct. So help me God. Patten Drilling Company, Inc.

(Signature) By Robert W. Patten

505 Opheum Bldg. Wichita 2, Kansas.

SUBSCRIBED AND SWORN TO before me this 13th day of December, 19 56

T. P. Hendrick
Notary Public.

My commission expires October 4th 1960

PLUGGING
FILE SEC. 27 T. 34 R. 15W
BOOK PAGE 123 LINE 43

LIVED
14 1956
12-14-56
CONSERVATION DIVISION
Wichita, Kansas

William Gruenerwald
Ballet Well # 1
Total Depth 5500'
Comm. 11/3/56
Comp. 12/8/56
Contractor Patton Drilling Co., Inc.

Location NE/4 NW/4 Sec. 27-T34S-R15W
Barber County, Kansas.
CASING RECORD
13 3/8" Casing at 75'
Cemented with 100 Sacks Cement
8 5/8" Casing at 824'
Cemented with 400 Sacks Cement

Sand	30
Red Beds	75
Red Bed & Shale	836
Shale & Shells	1730
Shale & Lime	1940
Anhydrite	2030
Lime & Shale	3682
Lime Sandy Shale	3779
Lime & Shale	3901
Shale, Lime & Sand	3971
Shale	4046
Lime & Shale	4236
Lime	4560
Lime & Shale	4599
Lime	4714
Lime & Shale	4773
Cherty Lime	4835
Lime & Shale	5150
Lime	5217
Cherty Lime	5239
Lime	5322
Sandy Shale & Sand	5340
Shale & Sand	5404
Sandy Shale & Sand	5440
Sand & Shale	5451
Lime	5500
Total Depth	5500

STATE OF Kansas COUNTY OF Sedgwick SS,

I, the undersigned, being duly sworn, on oath state that the above, statement and log is a true and correct record and log of the well drilled at the location above described.

PATTON DRILLING COMPANY, INC.

By Robert W. Patton

Subscribed and sworn to before me this 13th day of December 1956

T. P. Hendrick
Notary Public
T. P. Hendrick

My Commission Expires Oct. 4th 1960

