


STATE OF KANSAS  
STATE CORPORATION COMMISSION

WELL PLUGGING RECORD

Give All Information Completely  
Make Required Affidavit  
Mail or Deliver Report to:  
Conservation Division  
State Corporation Commission  
211 No. Broadway  
Wichita, Kansas

NORTH

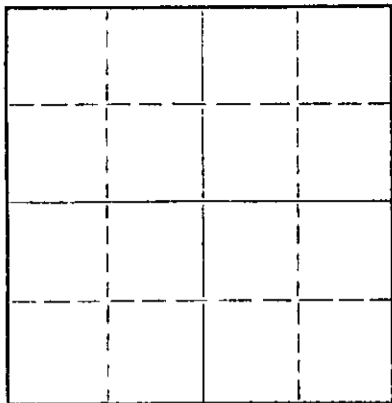

Locate well correctly on above  
Section Plat

Barber County, Sec. 20 Twp. 34 Rge. 15 (E) W (W)  
Location as "NE/CNW%SW%" or footage from lines SW SW SW  
Lease Owner Honaker-Davis Drlg. Co.  
Lease Name Winters Well No. 1  
Office Address 2008 Lakin, Great Bend, Kansas  
Character of Well (completed as Oil, Gas or Dry Hole) Dry Hole  
Date well completed 3-7 19 58  
Application for plugging filed 3-7 19 58  
Application for plugging approved 3-7 19 58  
Plugging commenced 12:01 A.M. 3-8 19 58  
Plugging completed 4:00 A.M. 3-8 19 58  
Reason for abandonment of well or producing formation \_\_\_\_\_

If a producing well is abandoned, date of last production \_\_\_\_\_ 19\_\_\_\_  
Was permission obtained from the Conservation Division or its agents before plugging was com-  
menced? yes

Name of Conservation Agent who supervised plugging of this well W. L. LaKamp  
Producing formation \_\_\_\_\_ Depth to top \_\_\_\_\_ Bottom \_\_\_\_\_ Total Depth of Well 5231 Feet  
Show depth and thickness of all water, oil and gas formations.

OIL, GAS OR WATER RECORDS

CASING RECORD

FORMATION	CONTENT	FROM	TO	SIZE	PUT IN	PULLED OUT
				8 5/8	900	None

Describe in detail the manner in which the well was plugged, indicating where the mud fluid was placed and the method or methods used in introducing it into the hole. If cement or other plugs were used, state the character of same and depth placed, from \_\_\_\_\_ feet to \_\_\_\_\_ feet for each plug set.

Filled hole with heavy rotary mud to 850'. Set Plug. Mixed 5 sacks cement by hand. Put through drillpipe. Filled hole with heavy rotary mud to 220'. Set plug. Dumped in 1/3 sack hulls. Mixed 20 sacks cement by hand. Put through drill pipe. Filled hole with heavy rotary mud to 40'. Set plug. Dumped in 1/3 sack hulls. Mixed 10 sacks cement. Cement filled hole to bottom of cellar.

RECEIVED  
STATE CORPORATION COMMISSION  
3-11-58  
MAR 11 1958

CONSERVATION DIVISION  
Wichita, Kansas

(If additional description is necessary, use BACK of this sheet)

Name of Plugging Contractor \_\_\_\_\_  
Address \_\_\_\_\_

STATE OF Kansas, COUNTY OF Barton, ss.  
J. T. Bowen (employee of owner) or (owner or operator) of the above-described well, being first duly sworn on oath, says: That I have knowledge of the facts, statements, and matters herein contained and the log of the above-described well as filed and that the same are true and correct. So help me God.

(Signature) J. T. Bowen  
Great Bend, Kansas  
(Address)

SUBSCRIBED AND SWORN TO before me this 10th day of March, 1958

My commission expires 6-25-59

Kenneth G. Fischer  
Notary Public.

PLUGGING  
FILE SEC. 20 T. 34 R. 15 W  
BOOK PAGE 88 LINE 36

DRILLERS' LOG

Winters No. 1  
Loc: SW SW SW  
Sec: 20-34S-15W  
Barber County, Kansas  
Company: Honaker-Davis Drlg. Co., et al  
Contractor: Honaker-Davis Drlg. Co.


Comm: 2-14-58  
Comp: 3- 8-58  
Rotary Total Depth: 5231'  
Casing: 8 5/8" at 897'  
D & A

0	210	Red Bed	8 5/8" casing cemented
210	1670	Shale & Shells	at 897' with 600 sacks
1670	1720	Gyp, Salt, Shale, Anhydrite	common cement, 2% jel
1720	1850	Shale & Shells	and 2% calcium chloride.
1850	1900	Shale & Gyp with Lime	
1900	2125	Shale & Lime	
2125	2355	Lime & Shale	
2355	2688	Shale & Lime	
2688	2835	Shale & Shells	
2835	3059	Shale	
3059	3405	Shale & Shells	
3405	3452	Lime & Shale	
3452	3505	Shale	
3505	3600	Shale, Shells & Lime	
3600	4065	Shale	
4065	4150	Shale & Lime	
4150	4179	Shale	
4179	5231	Lime	
5231		Total Rotary Depth	D & A

I certify that this is the true and correct copy of the above log to the best of my knowledge.

  
H. S. Forbes

Subscribed and sworn to before me this 10th day of March, 1958.

  
Kenneth G. Fischer, Notary Public

My commission expires: 6-25-59

PLUGGING  
FILE SEC. 20T. 34R. 15W  
BOOK PAGE 88 LINE 36

EX-107  
STATE GOVT  
MAR 11 1958  
COMM. DIVISION  
TOPEKA, KANSAS