

STATE OF KANSAS
STATE CORPORATION COMMISSION

Form CP-4

Give All Information Completely
Make Required Affidavit
Mail or Deliver Report to:
Conservation Division
State Corporation Commission
212 No. Market
Wichita, Kansas 67202

WELL PLUGGING RECORD

Barber County, Sec. 13 Twp. 34S Rge. 15W (E) (W)

Location as "NE/CNW/SW" or footage from lines C SE NW

Lease Owner Petroleum Management, Inc.

Lease Name Davis "A" Well No. 1

Office Address 400 N. Woodlawn, Suite 201, Wichita, Ks. 67208

Character of Well (completed as Oil, Gas or Dry Hole)

Date well completed 19

Application for plugging filed June 13 1979

Application for plugging approved June 15 1979


Plugging commenced August 29 1979

Plugging completed August 29 1979

Reason for abandonment of well or producing formation Dried up

If a producing well is abandoned, date of last production September 1 1973

Was permission obtained from the Conservation Division or its agents before plugging was commenced? Yes

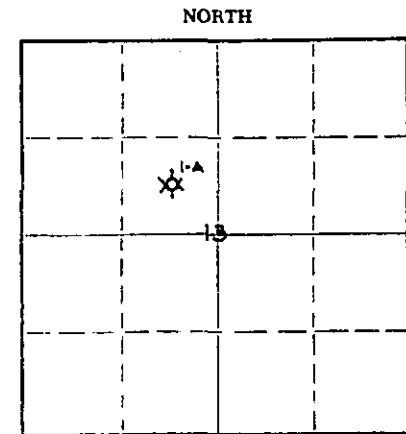

Locate well correctly on above Section Plat

Name of Conservation Agent who supervised plugging of this well William T. Owen

Producing formation Mississippi Depth to top 4839 Bottom Total Depth of Well 4880 Feet

Show depth and thickness of all water, oil and gas formations.

OIL, GAS OR WATER RECORDS


CASING RECORD

FORMATION	CONTENT	FROM	TO	SIZE	PUT IN	PULLED OUT

Describe in detail the manner in which the well was plugged, indicating where the mud fluid was placed and the method or methods used in introducing it into the hole. If cement or other plugs were used, state the character of same and depth placed, from feet to feet for each plug set.

Plugged well using Halliburton Cementing Co. as follows:

Pumped 25 sacks 50-50 pozmix, followed with 5 sacks cotton seed hulls, 20 sacks gel, 125 sacks 50-50 pozmix with 3% gel on 8/29/79.

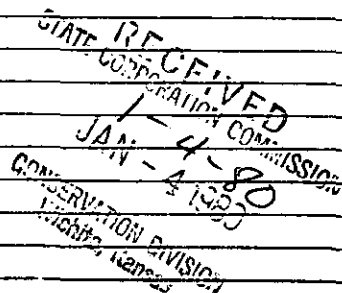

(If additional description is necessary, use BACK of this sheet)

Name of Plugging Contractor Petroleum Management, Inc.

Address 400 N. Woodlawn, Suite 201, Wichita, Ks. 67208

STATE OF KANSAS, COUNTY OF SEDGWICK, ss.

Dale Silcott

(employee of owner) or (owner or operator) of the above-described well, being first duly sworn on oath, says: That I have knowledge of the facts, statements, and matters herein contained and the log of the above-described well as filed and that the same are true and correct. So help me God.

(Signature) Dale Silcott, Vice President

400 N. Woodlawn, Ste. 201, Wichita, Ks. 67208 (Address)

SUBSCRIBED AND SWORN TO before me this 2nd day of January, 1980

Bonnie Brown

Bonnie Brown

Notary Public.

My commission expires March 1, 1981



LOG

Company: M. B. Arner
Contractor: Mid-America Drillers, Inc.
Drilling Commenced: 6/23/52
Drilling Completed: 7/17/52

Farm: Davis #1
Location: C SE/4 NW/4 Sec. 13-34S-15W
Barber County, Kansas
Casing Records: 8-5/8" casing set at
360' with 250 sacks of cement.
5 1/2" casing set at 4854' with
75 sacks of cement.

(figures below indicate bottoms)

Clay	160
Redbed	359
Shale	380
Redbed, shells & shale	920
Redbed & shells	1300
Shale & shells	1600
Shale & shells	1757
Shale & shells	1985
Sandy shale	2065
Shale and shells	2170
Shale & shells	2250
Lime & shale	2410
Sandy lime & shale	2465
Lime & shale	3130
Broken lime & shale	3167
Lime & shale	3485
Sandy lime	3520
Shale & lime	3590
Shale	3670
Shale & lime	3940
Sandy Lime & shale	4011
Lime & shale	4130
Lime	4145
Lime & shale	4225
Lime	4585
Broken lime	4615
Lime	4690
Lime & shale	4791
Lime	4805
Shale & lime	4830
Lime	4860
R. T. D.	4860

RECEIVED
STATE CORP

JUN 15 1979

CONSERVATION DIVISION
Wichita, Kansas

I hereby certify that this is a true and correct log of the above described well as shown by the drilling reports.

Wm. F. PIELSTICKER

/s/

Wm. F. Pielsticker

STATE OF KANSAS)
) SS
COUNTY OF SEDGWICK)

Subscribed and sworn to before me, a Notary Public, in and for said County and State this 25th day of July, 1952.

/s/

Ruth H. Heskot
Notary Public

My commission expires: Nov. 5, 1955.