


STATE OF KANSAS
STATE CORPORATION COMMISSION

Form CP-4

Give All Information Completely
Make Required Affidavit
Mail or Deliver Report to:
Conservation Division
State Corporation Commission
212 No. Market
Wichita, Kansas 67202

WELL PLUGGING RECORD

NORTH

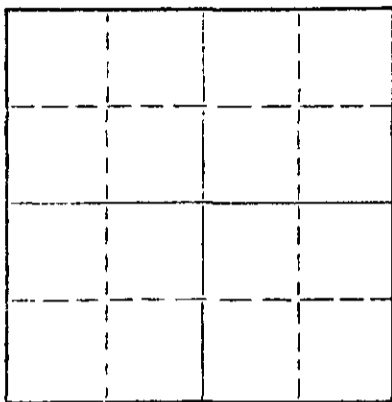

Locate well correctly on above
Section Plat

Barber County, Sec. 7 Twp. 34S. Rge. 15 XEX W (W)
Location as "NE/CNWSW" or footage from lines 189' N of C SE SE
Lease Owner Se Ro Bee Drilling Company, Inc.
Lease Name Carthrae Well No. 1-A
Office Address 256 North Topeka, Wichita, Kansas 67202
Character of Well (completed as Oil, Gas or Dry Hole) Dry hole
Date well completed August 26, 19 72
Application for plugging filed August 26, 19 72
Application for plugging approved August 26, 19 72
Plugging commenced August 26, 19 72
Plugging completed August 26, 19 72
Reason for abandonment of well or producing formation No productible zone

If a producing well is abandoned, date of last production 19
Was permission obtained from the Conservation Division or its agents before plugging was commenced? Yes

Name of Conservation Agent who supervised plugging of this well G. R. Biberstein
Producing formation Depth to top Bottom Total Depth of Well 4820 Feet
Show depth and thickness of all water, oil and gas formations.

OIL, GAS OR WATER RECORDS

CASING RECORD

FORMATION	CONTENT	FROM	TO	SIZE	PUT IN	PULLED OUT
				20"	124	0
				13"	247	0

Describe in detail the manner in which the well was plugged, indicating where the mud fluid was placed and the method or methods used in introducing it into the hole. If cement or other plugs were used, state the character of same and depth placed, from feet to feet for each plug set.

Gunned up pits forming heavy mud. Filled hole with heavy mud and spotted 65 sacks cement at 400 feet. Filled hole with heavy mud and pushed 1 sack hulls and wooden plug to 40 feet, capped with 15 sacks cement to base of well cellar. Plugged rat hole and mouse hole with 2 sacks cement each. Job complete at 11:30 PM 8-26-72/.

RECEIVED
STATE CORPORATION COMMISSION
SEP 8 1972
CONSERVATION DIVISION
Wichita, Kansas

(If additional description is necessary, use BACK of this sheet)
Name of Plugging Contractor Garvey Drilling Company
Address Box 1164, Great Bend, Kansas 67530

STATE OF Kansas, COUNTY OF Barton, ss.
Ben E. Unruh (employee of owner) of the above-described well, being first duly sworn on oath, says: That I have knowledge of the facts, statements, and matters herein contained and the log of the above-described well as filed and that the same are true and correct. So help me God.

(Signature) Ben E. Unruh
Box 1164, Great Bend, Kansas 67530
(Address)

SUBSCRIBED AND SWORN to before me this September 19 19 72
My commission expires July 8, 1974



Notary Public.

WELL LOG

COMPANY SeRoBee Drilling Company

SEC. 7 T. 3S R. 15W

FARM Carthrae No. A-1

LOC. 189' E NE of SE SE

TOTAL DEPTH 4820'


COUNTY Barber, Kansas

COMM. 8-16-72 COMP. 8-26-72

CONTRACTOR Garvey Drilling Company

CASING

20" @ 124' w/425sx
13" @ 247' w/290sx

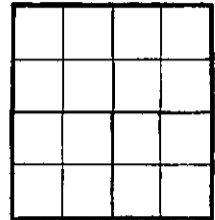

ELEVATION

PRODUCTION D & A

FIGURES INDICATE BOTTOM OF FORMATIONS

225' Red Bed & Sand
250' Red Bed & Shale
280' Shale
1410' Shale & Shells
1700' Shale
1800' Shale & Lime
2045' Lime & Shale
2182' Lime
2685' Lime & Shale
4285' Cherty Lime & Shale
4375' Lime
4820' Lime
4820' RTD


RECEIVED
STATE CORPORATION COMMISSION
SEP 8 1972
CONSERVATION DIVISION
Wichita, Kansas

State of Kansas }
County of Barton } ss

I, Charlene Marker of Garvey Drilling Company
upon oath state the above and foregoing is a true and correct copy of the log of the Carthrae No. 1-A well.

Subscribed and sworn to before me this 29th day of August 19 72

My Commission Expires: July 28, 1974

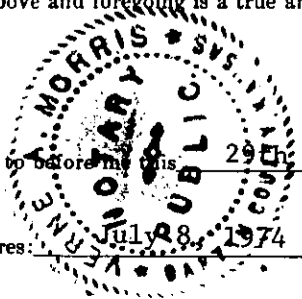

Charlene Marker
James A. D. [Signature]
NOTARY PUBLIC