


15-077-20757-00-00

STATE OF KANSAS
STATE CORPORATION COMMISSION

WELL PLUGGING RECORD

Give All Information Completely
Make Required Affidavit
Mail or Deliver Report to
Conservation Division
State Corporation Comm.
245 North Water
Wichita, KS 67202

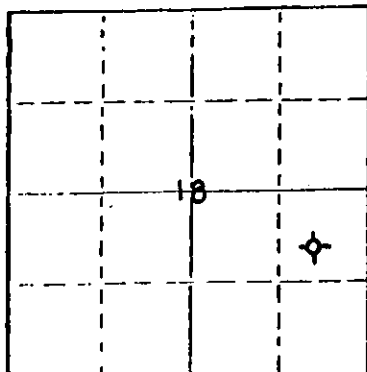

Locate well correctly on above
Section Plat

Harper County, Sec. 18 Twp. 31S Rge. 4 E/W
Location as "NE/CNW $\frac{1}{4}$ SW $\frac{1}{4}$ " or footage from lines
140' SW C NE SE

Lease Owner PICKRELL DRILLING COMPANY

Lease Name Depenbusch 'C' Well No. 1

Office Address 110 N. Market Suite 205

Character of Well (Completed as Oil, Gas or Dry Hole)
Dry Hole

Date Well completed 12/10/81 19

Application for plugging filed 12/10/81 19

Application for plugging approved 12/10/81 19

Plugging commenced 12/10/81 19

Plugging completed 12/10/81 19

Reason for abandonment of well or producing formation

D & A

If a producing well is abandoned, date of last production
19

Was permission obtained from the Conservation Division or
its agents before plugging was commenced? Yes

Name of Conservation Agent who supervised plugging of this well

Producing formation N/A Depth to top Bottom Total Depth of Well 4515'

Show depth and thickness of all water, oil and gas formations.

OIL, GAS OR WATER RECORDS

CASING RECORD

| FORMATION | CONTENT | FROM | TO | SIZE | PUT IN | PULLED OUT |
|-----------|---------|------|----|--------|--------|------------|
| | | | | 8 5/8" | 208' | None |
| | | | | | | |
| | | | | | | |
| | | | | | | |

Describe in detail the manner in which the well was plugged, indicating where the mud fluid was placed and the method or methods used in introducing it into the hold. If cement or other plugs were used, state the character of same and depth placed, from _____ feet to _____ feet for each plug set.

60 Sx @ 520'

40 Sx @ 200'

10 Sx @ 40' w/solid bridge plug

10 Sx in Rathole

(If additional description is necessary, use BACK of this sheet)


Name of Plugging Contractor PICKRELL DRILLING COMPANY

STATE OF KANSAS COUNTY OF SEDGWICK, ss.
C. W. SEBITS (employee of owner) or (owner or operator)
of the above-described well, being first duly sworn on oath, says: That I have knowledge of the facts, statements, and matters herein contained and the log of the above-described well as filed and that the same are true and correct. So help me God.

(Signature)

PICKRELL DRILLING COMPANY

(Address)

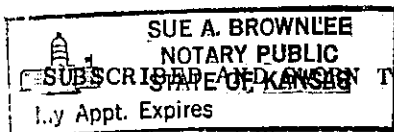

SUE A. BROWNLEE

NOTARY PUBLIC

STATE OF KANSAS

My Appt. Expires

Subscribed and sworn to before me this 16 day of December, 1981

My commission expires

February 24, 1985

Notary Public.

RECEIVED
STATE CORPORATION COMMISSION
12-18-81
DEC 18 1981

CONSERVATION DIVISION
Wichita, Kansas