

WELL PLUGGING RECORD

Give All Information Completely
Make Required Affidavit
Mail or Deliver Report to:
Conservation Division
State Corporation Commission
800 Bitting Building
Wichita, Kansas

Harper County, Sec. 17 Twp. 31 Rge. 9 (E) (W)

Location as "NE/CNW/SW" or footage from lines NW NW NE

Lease Owner Petroleum, Inc.

Lease Name ANTHONY 'D' Well No. 1

Office Address 311 East Third, Wichita, Kansas

Character of Well (completed as Oil, Gas or Dry Hole) Dry Hole

Date well completed April 15, 1955

Application for plugging filed April 15, 1955

Application for plugging approved April 15, 1955

Plugging commenced April 15, 1955

Plugging completed April 15, 1955

Reason for abandonment of well or producing formation Dry Hole

If a producing well is abandoned, date of last production 19

Was permission obtained from the Conservation Division or its agents before plugging was commenced? Yes

Name of Conservation Agent who supervised plugging of this well Mr. M. A. Rives

Producing formation Depth to top Bottom Total Depth of Well 1780 Feet

Show depth and thickness of all water, oil and gas formations.

OIL, GAS OR WATER RECORDS

CASING RECORD

FORMATION	CONTENT	FROM	TO	SIZE	PUT IN	PULLED OUT
				8-5/8"	258'	None

Describe in detail the manner in which the well was plugged, indicating where the mud fluid was placed and the method or methods used in introducing it into the hole. If cement or other plugs were used, state the character of same and depth placed, from feet to feet for each plug set.

Mudded up to 254' and set first

wooden plug at 254'. Displaced

20 sacks cement through drill

pipe from 254 to 200'. Mudded

up to 15' and set second wooden

plug at 15' and displace 5 sacks

cement to base of well cellar.

(If additional description is necessary, use BACK of this sheet)

Name of Plugging Contractor Garvey Drilling Company

Address R. R. #2 - Great Bend, Kansas

STATE OF KANSAS, COUNTY OF SEDGWICK, ss.

Karl E. Becker (employee of owner) of the above-described well, being first duly sworn on oath, says: That I have knowledge of the facts, statements, and matters herein contained and the log of the above-described well as filed and that the same are true and correct. So help me God.

(Signature) Karl E. Becker

311 East Third, Wichita, Kansas (Address)

SUBSCRIBED AND SWORN TO before me this 29th day of April, 1955

My commission expires 8-11-58

Notary Public.

PLUGGING
FILE SEC 17 T 31 R 9W
BOOK PAGE 111 LINE 20

RECEIVED
STATE CORPORATION COMMISSION
5-3-55
CONSERVATION DIVISION
Wichita, Kansas

WELL LOG

COMPANY **Petroleum, Inc.**

SEC. 17 T. 31 R. 9

FARM **ANTHONY 'D'**

NO. 1

LOC. NW NW NE


TOTAL DEPTH **4780'**

COUNTY **Harper**

COMM. **March 28, 1955**

COMP. **April 14, 1955**

CONTRACTOR **Garvey Drilling Company**

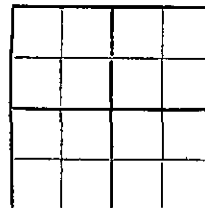

CASING **8-5/8" @ 258' w/200 sax.**

ELEVATION **1726' HB**

PRODUCTION **D & A**

FIGURES INDICATE BOTTOM OF FORMATIONS

150	Clay & Sand
258	Red Bed & Shells
475	Red Bed
950	Shale & Sand Streaks
1025	Sand
1615	Shale & Shells
1630	Lime & Shale
1677	Sandy Lime
3710	Lime & Shale
3766	Shale
3778	Sand
4195	Lime
4615	Shale & Lime
4660	Chert & Lime
4675	Lime
4730	Shale
4780	Lime & Shale
4780	RFD

Tops:

Heebner:	3566 (-1810)
Toronto:	3595 (-1869)
Douglas:	3611 (-1885)
Lansing:	3766 (-2040)
HKC:	4266 (-2540)
Conglomerate:	4437 (-2711)
Mississippi:	4611 (-2915)
Viola:	4770 (-3044)

State of **KANSAS**

County of **SEDGWICK**

SS:

I, **Karl E. Becker**


of **Petroleum, Inc.**

REGISTRATION DIVISION
Topeka, Kansas

upon oath state that the above and foregoing is a true and correct copy of the log of the **ANTHONY 'D' #1** well.

Subscribed and sworn to before me this **29th** day of **April**, 19 **55**

My Commission Expires: **8-11-58**

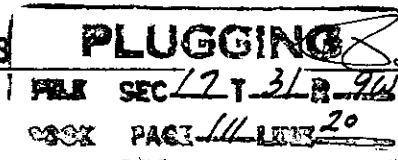

NOTARY PUBLIC

Karl E. Becker