

STATE OF KANSAS
STATE CORPORATION COMMISSION


Give All Information Completely
Make Required Affidavit
Mail or Deliver Report to:
Conservation Division
State Corporation Commission
211 No. Broadway
Wichita, Kansas

WELL PLUGGING RECORD

Harper County. Sec. 5 Twp. 32S Rge. 6W (E) (W)
Location as "NE/CNW/SW" or footage from lines C. NW NW
Lease Owner Time Petroleum Company
Lease Name Hedrick Well No. 1
Office Address 815 Union National Bldg., Wichita, Kansas
Character of Well (completed as Oil, Gas or Dry Hole) Dry Hole
Date well completed 5-18-62 19
Application for plugging filed 5-18-62 19
Application for plugging approved 5-18-62 19
Plugging commenced 5-18-62 19
Plugging completed 5-18-62 19
Reason for abandonment of well or producing formation Dry Hole

If a producing well is abandoned, date of last production 19
Was permission obtained from the Conservation Division or its agents before plugging was commenced? yes

Name of Conservation Agent who supervised plugging of this well Fred Hampel, Pretty Prairie
Producing formation Depth to top Bottom Total Depth of Well 4803 Feet
Show depth and thickness of all water, oil and gas formations.

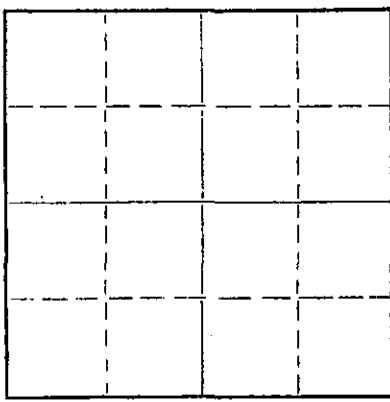

Locate well correctly on above Section Plat

OIL, GAS OR WATER RECORDS

CASING RECORD

FORMATION	CONTENT	FROM	TO	SIZE	PUT IN	PULLED OUT
				8 5/8"	300'	None

Describe in detail the manner in which the well was plugged, indicating where the mud fluid was placed and the method or methods used in introducing it into the hole. If cement or other plugs were used, state the character of same and depth placed, from feet to feet for each plug set.

1st Plug set at 280' with 20 sacks of cement

2nd Plug set at 40' with 10 sacks of cement and 1/2 sack of hulls

RECEIVED
STATE CORPORATION COMMISSION
5-29-62
MAY 29 1962
CONSERVATION DIVISION
Wichita, Kansas

(If additional description is necessary, use BACK of this sheet)

Name of Plugging Contractor Leben Drilling, Inc.
Address P. O. Box 486, Great Bend, Kansas

STATE OF KANSAS, COUNTY OF BARTON, ss.
Byron Johnson (employee of owner) or (owner or operator) of the above-described well, being first duly sworn on oath, says: That I have knowledge of the facts, statements, and matters herein contained and the log of the above-described well as filed and that the same are true and correct. So help me God.

(Signature) Byron Johnson
P. O. Box 486, Great Bend, Kansas
(Address)

SUBSCRIBED AND SWORN TO before me this 26th day of May, 1962

Ulanda Nichols
Notary Public.

My commission expires April 1, 1963



DRILLER'S LOG

COMPANY: Time Petroleum
 CONTRACTOR: LEBEN DRILLING, INC.
 FARM: HEDRICK #1
 LOCATION: C NW NW Sec. 5-32S-6W
 HARPER COUNTY, KANSAS
 COMMENCED: 4-30-62
 COMPLETED: 5-18-62

0	45	Clay & Sand
45	300	Sand & Shale
300	550	Shale & Redbed
550	840	Shale
840	1105	Shale & Shells
1105	1165	Anhydrite
1165	1615	Shale & Lime
1615	1715	Lime
1715	1975	Shale with Lime
1975	2225	Shale with Lime Streaks
2225	2380	Shale & Lime
2380	2640	Shale & Lime Shells
2640	2870	Shale
2870	2970	Shale & Lime
2970	3130	Lime
3130	3521	Lime & Shale
3521	3615	Shale
3615	3765	Lime & Shale
3765	3989	Lime
3989	4050	Lime & Shale
4050	4235	Lime
4235	4346	Shale & Lime
4346	4367	Mississippi Lime & Chert
4367	4438	Lime (Mississippi)
4438	4550	Lime & Shale
4550	4625	Mississippi Cherty Lime
4625	4761	Shale & Lime
4761	4770	Dolemetes Sand
4770	4788	Shale, Lime & Sand
4788	4803	Sand
	<u>4803</u>	<u>Rotary Total Depth - D. & A.</u>

RECEIVED
 STATE CORPORATION COMMISSION
 MAY 29 1962
 CONSERVATION DIVISION
 Wichita, Kansas


Set 8 5/8" surface casing @ 300' with 200 sacks of Quickset cement by Globe.

I, Byron Johnson, do hereby certify that the above and foregoing is a true and correct copy of the log of the Hedrick #1 located C NW NW of Section 5, Township 32 South, Range 6 West, Harper County, Kansas as reflected by the files of Leben Drilling, Inc.


 Byron Johnson

STATE OF KANSAS)
) SS
 COUNTY OF BARTON)

Subscribed and sworn to before me, a Notary Public, in and for Barton County, Kansas, this 26th day of May, 1962.

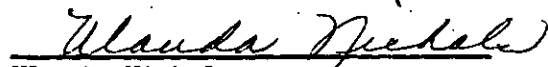
 Ulanda Nichols

My Commission Expires:
 April 1, 1963