


WELL PLUGGING RECORD

Give All Information Completely  
Make Required Affidavit  
Mail or Deliver Report to:  
Conservation Division  
State Corporation Commission  
212 No. Market  
Wichita, Kansas

NORTH

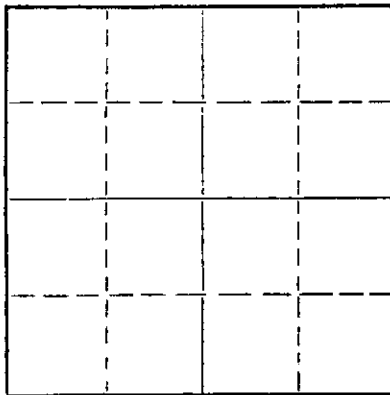

Locate well correctly on above  
Section Plat

HARPER

County, Sec. 32 Twp. 32S Rge. (E) 5 (W)

Location as "NE/CNW/SW" or footage from lines CENTER OF NW OF SW

Lease Owner DOBSET COMPANY

Lease Name MOTT

Well No. 1

Office Address 610 NATIONAL BANK OF TULSA BLDG, TULSA, OKLA

Character of Well (completed as Oil, Gas or Dry Hole) DRY

Date well completed 4-8 19 67

Application for plugging filed 5-12 19 67

Application for plugging approved 5-15 19 67

Plugging commenced 5-15 19 67

Plugging completed 5-20 19 67

Reason for abandonment of well or producing formation DRY

If a producing well is abandoned, date of last production 19

Was permission obtained from the Conservation Division or its agents before plugging was commenced? YES

Name of Conservation Agent who supervised plugging of this well A. V. ELVING

Producing formation Depth to top Bottom Total Depth of Well 3733 Feet

Show depth and thickness of all water, oil and gas formations.

OIL, GAS OR WATER RECORDS

CASING RECORD

FORMATION	CONTENT	FROM	TO	SIZE	PUT IN	PULLED OUT
				8-5/8"	281.47'	0
				5 1/2"		3192.82'

Describe in detail the manner in which the well was plugged, indicating where the mud fluid was placed and the method or methods used in introducing it into the hole. If cement or other plugs were used, state the character of same and depth placed, from feet to feet for each plug set.

PLUGGED BOTTOM WITH 5 SACKS CEMENT

BRIDGE AT 260'

ROCK TO 250'

DUMPED 20 SACKS

MUD TO 40'

10 SACKS CEMENT TO SURFACE

RECEIVED  
STATE CORPORATION COMMISSION  
MAY 24 1967

CONSERVATION DIVISION  
Wichita, Kansas

(If additional description is necessary, use BACK of this sheet)

Name of Plugging Contractor WINFIELD OIL FIELD SERVICE, INC.

Address P. O. Box 952, WINFIELD, KANSAS

STATE OF KANSAS, COUNTY OF HARPER, ss.

OLEN S. KTER

(employee of owner) or (owner or operator) of the above-described well, being first duly sworn on oath, says: That I have knowledge of the facts, statements, and matters herein contained and the log of the above-described well as filed and that the same are true and correct. So help me God.

(Signature)

2101 EAST 9TH ST., WINFIELD, KANS.

(Address)

SUBSCRIBED AND SWORN TO before me this 23RD day of MAY, 19 67

My commission expires

JULY 13, 1970

Anna L. Smith

Notary Public.

MOTT # 1

Dorset Company

Total depth: 3733'

Contractor: Donelson Drilling Co.

Commenced: 4/3/67

Completed: 4/8/67

Elevation: 1365 KB 1360 GL

Location: C NW SW

Section: 32-32S-5W

Harper County, Kansas

Casing Record: 8 5/8" O.D. set @ 281.47 w/225 sks.

Formation:

Surface hole

Shale

Shale & lime stks.

Shale

Lime & Shale stks.

Shale & Lime

Lime & Shale

Sand & Shale

Lime & Shale

Lime (K.C.)

Depth:

281'

960'

1360'

1398'

1648'

2315'

3510'

3547'

3713'

3733' TD

RECEIVED  
STATE CORPORATION COMMISSION  
MAY 15 1967  
CONSERVATION DIVISION  
Wichita, Kansas

I hereby certify the foregoing statements are true and correct to the best of my knowledge and belief.

DONELSON DRILLING COMPANY

By James L. Donelson  
James L. Donelson

STATE OF KANSAS )  
                          ) SS  
COUNTY OF SEDGWICK )

Subscribed and sworn to before me, a Notary Public in and for said county and state, this 10<sup>th</sup> day of April, 1967.

Caroline L. Scott  
Notary Public

My Commission expires: April 16, 1969